

SURVEY & REMONUMENTATION

1993

CHEBOYGAN COUNTY REMONUMENTATION CORNER  
LAND CORNER RECORDATION CERTIFICATE  
Filing Requirement of Act 74, Mich. P.A. 1970

COMMISSION

For corners in

CHEBOYGAN  
(County)

Located In:

Corner Code #

- |                                       |                          |            |
|---------------------------------------|--------------------------|------------|
| 1. Public Land Survey                 | T <u>37N</u> R <u>1E</u> | <u>A-9</u> |
|                                       | T _____ R _____          | _____      |
|                                       | T _____ R _____          | _____      |
|                                       | T _____ R _____          | _____      |
| 2. Property Controlling in Section    | S _____ T _____ R _____  | _____      |
|                                       | S _____ T _____ R _____  | _____      |
| 3. Miscellaneous Property in Sec.     | S _____ T _____ R _____  | _____      |
|                                       | S _____ T _____ R _____  | _____      |
| 4. Lot No. _____, Recorded Plat _____ |                          |            |
| 5. Private Claims _____               |                          |            |

RECEIVED FOR RECORD

93 DEC 22 AM 10:46

*James Spray*  
CLERK/REGISTER  
CHEBOYGAN COUNTY, MICHIGAN

Register of Deeds Stamp & File Number

I, Ronald R. Bischer, in a field survey on September 20, 19 93, do hereby certify that under requirements of P.A. 74, Michigan P.A. of 1970, the corner points mentioned in lines 1 and 2 above were in conformance with regulations and rules therefore as required in the current manual of survey instructions of the United States Department of the Interior, Bureau of Land Management or by a decree of a Court of Law and/or that the corner points mentioned in lines 3, 4 and 5 above were in conformance with the rules of the Michigan Board of Land Surveyors or by a Decree of a Court of Law; established, re-established, monumented, re-monumented, recovered, found as expressed below:

NOTE: Not more than 4 corners, all in the same town and range, may be recorded on this certificate.

A. Description of original monument and accessories and/or subsequent restoration:

A-9  
Original Survey - June 21, 1840  
John Hodgson set Wood Post  
7" Cedar S17°E 7 links  
7" Cedar N49°W 9 links  
1854 Resurvey - Geo. H. Cannon  
found and used Wood Post set  
by John Hodgson

1963 - Kenneth J. Ostling  
Found 1-½" Pipe  
S80°W 10.4' 6" Balsam  
S34°E 9.5' 5" Balsam

B. Description of corner evidence found and/or method applied in restoring or reestablishing corner:

A-9  
Found 1-½" Pipe  
S80°W 10.4' 7" Balsam  
witness is dead but still standing  
S34°E 9.5' 6" Balsam  
witness is dead but still standing


Replaced 1-½" Pipe with Cheboygan County Remonumentation Monument.

C. Description of monument for corner and accessories established to perpetuate locating the position of the corner:

A-9  
Cheboygan County Remonumentation Monument  
S64°W 38.98' 6" Balsam  
S23°E 66.97' 5" Cedar  
N49°W 44.12' 7" Cedar  
N87°E 25.75' 6" Black Ash

Set nail with witness tag #22428 in witnesses.

	A	B	C	D	E	F	G	H	I	J	K	L	M
2	6	5	4	3	2	1							
3													
4	7	8	9	10	11	12							
5													
6	18	17	16	15	14	13							
7													
8	19	20	21	22	23	24							
9													
10	30	29	28	27	26	25							
11													
12	31	32	33	34	35	36							
13													

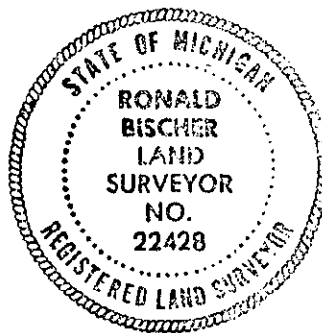

LIBER 010 PAGE 25

Signed by Ronald R. Bischer

Date 12-03-93

Surveyor's Michigan License No. 22428

*Martin A. R...*

