

SURVEY &  
REMONUMENTATION

1993

CHEBOYGAN COUNTY REMONUMENTATION CORNER  
LAND CORNER RECORDATION CERTIFICATE  
Filing Requirement of Act 74, Mich. P.A. 1970

For corners in COMMISSION

<u>CHEBOYGAN</u> (County)	Located In:	Corner Code #
1. Public Land Survey	T <u>37N</u> R <u>1E</u>	<u>A-11</u>
	T _____ R _____	_____
	T _____ R _____	_____
	T _____ R _____	_____
2. Property Controlling in Section	S _____ T _____ R _____	_____
	S _____ T _____ R _____	_____
3. Miscellaneous Property in Sec.	S _____ T _____ R _____	_____
	S _____ T _____ R _____	_____
4. Lot No. _____, Recorded Plat _____		
5. Private Claims _____		

RECEIVED  
FOR RECORD  
93 DEC 22 AM 10:37  
*James Granger*  
Register of Deeds Stamp & File Number  
CHEBOYGAN COUNTY, MICHIGAN


I, Ronald R. Bischer in a field survey on September 20, 19 93, do hereby certify that under requirements of P.A. 74, Michigan P.A. of 1970, the corner points mentioned in lines 1 and 2 above were in conformance with regulations and rules therefore as required in the current manual of survey instructions of the United States Department of the Interior, Bureau of Land Management or by a decree of a Court of Law and/or that the corner points mentioned in lines 3, 4 and 5 above were in conformance with the rules of the Michigan Board of Land Surveyors or by a Decree of a Court of Law; established, re-established, monumented, re-monumented, recovered, found as expressed below:

	A	B	C	D	E	F	G	H	I	J	K	L	M
2	6	5	4	3	2	1							
3													
4	7	8	9	10	11	12							
5													
6	18	17	16	15	14	13							
7													
8	19	20	21	22	23	24							
9													
10	30	29	28	27	26	25							
11													
12	31	32	33	34	35	36							
13													

NOTE: Not more than 4 corners, all in the same town and range, may be recorded on this certificate.

A. Description of original monument and accessories and/or subsequent restoration:

A-11 1840 Original Survey (June 21) 1989 - James Granger  
John Hodgson set Wood Post Found 1/2" Pipe  
7" Cedar S17°E 5 links S62°W 59.82' Power pole  
10" Cedar N61°W 17 links S35°E 49.87' Fence Post  
1854 Resurvey - Geo. H. Cannon S08°E 68.39' Sign post  
Found and used post set by Hodgson N12°W 97.98' Power pole  
1951 - Joseph Doyle  
Set 1/2" Pipe

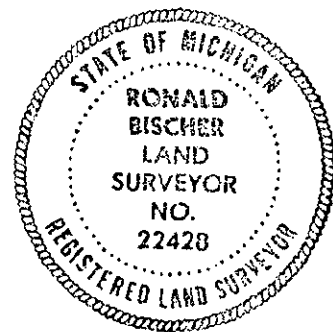

B. Description of corner evidence found and/or method applied in restoring or reestablishing corner:

A-11 Found 1/2" Pipe  
S57°W 59.53' Power pole  
S38°E 50.23' Fence post  
S10°E 68.56' Sign post  
N18°W 97.51' Power pole


Replaced 1/2" Pipe with Cheboygan County Remonumentation Monument

LIBER 010 PAGE 23

C. Description of monument for corner and accessories established to perpetuate locating the position of the corner:

A-11 Cheboygan County Remonumentation Monument  
S57°W 59.53' Power pole  
S38°E 50.23' Fence post  
S10°E 68.56' Sign post  
N18°W 97.51' Power pole

*Margaret A. Rose*

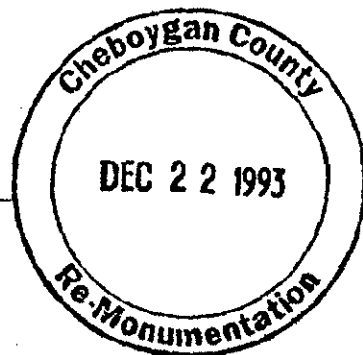

Drawn by Ronald R. Bischer

Date 12-03-93

Surveyor's Michigan License No. 22428