

1993

COMMISSION

CHEBOYGAN COUNTY REMONUMENTATION CORNER
LAND CORNER RECORDATION CERTIFICATE
Filing Requirement of Act 74, Mich. P.A. 1970

For corners in

CHEBOYGAN (County)	Located In:	Corner Code #
1. Public Land Survey	T <u>37N</u> R <u>1E</u>	<u>A-13</u>
	T _____ R _____	_____
	T _____ R _____	_____
	T _____ R _____	_____
2. Property Controlling in Section	S _____ T _____ R _____	_____
	S _____ T _____ R _____	_____
3. Miscellaneous Property in Sec.	S _____ T _____ R _____	_____
	S _____ T _____ R _____	_____
4. Lot No. _____, Recorded Plat _____		
5. Private Claims _____		

RECEIVED
FOR RECORD
93 DEC 22 AM 10:33

Joanna Spray
CLERK/REGISTER
CHEBOYGAN COUNTY, MICHIGAN
Register of Deeds Stamp & File Number

I, Ronald R. Bischer, in a field survey on September 20, 19 93, do hereby certify that under requirements of P.A. 74, Michigan P.A. of 1970, the corner points mentioned in lines 1 and 2 above were in conformance with regulations and rules therefore as required in the current manual of survey instructions of the United States Department of the Interior, Bureau of Land Management or by a decree of a Court of Law and/or that the corner points mentioned in lines 3, 4 and 5 above were in conformance with the rules of the Michigan Board of Land Surveyors or by a Decree of a Court of Law; established, re-established, monumented, re-monumented, recovered, found as expressed below.

NOTE: Not more than 4 corners, all in the same town and range, may be recorded on this certificate.

	A	B	C	D	E	F	G	H	I	J	K	L	M
2	6		5		4		3		2		1		
3													
4	7		8		9		10		11		12		
5													
6	18		17		16		15		14		13		
7													
8	19		20		21		22		23		24		
9													
10	30		29		28		27		26		25		
11													
12	31		32		33		34		35		36		
13													

A. Description of original monument and accessories and/or subsequent restoration:


A-13
June 12, 1840 Original Survey
John Hodgson set Wood Post Cor. Fence Post S40°W 39.30'
19" Beech N45°W 20 links Cor. Fence Post N36°W 42.00'
18" Beech S18°W 40 links 8" Elm N57°E 47.00'
1854 Resurvey - Geo. H. Cannon 1974 - Orlando Doyle
Found and used post set by Hodgson found pipe in place
1951 - Joseph Doyle set 1/2" pipe 1991 - Mark Ennes found 1/2" pipe
reset 1/2" rod after construction - set 4 witnesses

B. Description of corner evidence found and/or method applied in restoring or reestablishing corner:

A-13
Found 1/2" Rod in Monument Box
Found 4 witnesses set by Mark Ennes
S30°E 44.20' 14" Elm
N45°E 54.39' Telephone Riser (wood)
N50°W 46.98' Power pole
S40°W 63.82' Power pole

Replaced 1/2" Rod with Cheboygan County Remonumentation Monument in Monument Box


LIBER- 010 PAGE 21

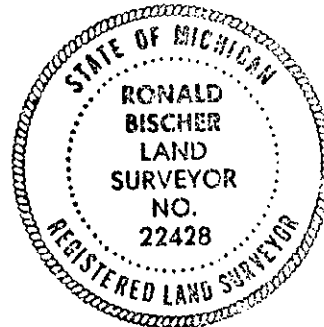

C. Description of monument for corner and accessories established to perpetuate locating the position of the corner:

A-13
Cheboygan County Remonumentation Monument in Monument Box
S30°E 44.20' 14" Elm
N45°E 54.24' Telephone Riser (wood)
N50°W 46.98' Power pole
S40°W 63.82' Power pole

Morris A. Ross

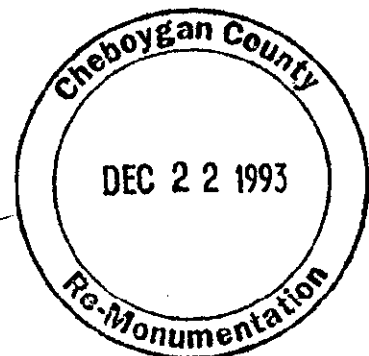

Signed by Ronald R. Bischer Date 12-3-93

Surveyor's Michigan License No. 22428