

MICHIGAN
DEPARTMENT OF CONSERVATION
FORESTRY DIVISION

LAND CORNER RECORD

T. 37. NR. 1. E.

Ch. 3an COUNTY

DESCRIPTION OF CORNER Section corner common to sections 8, 9, 16, 17

DESCRIPTION OF CORNER MONUMENT 1" Iron pipe with 4" Brass cap

WITNESSES TO CORNER 5" Spruce - N 73 W - 2.98 chains


5" Spruce - N 44 W - 2.88 chains

DESCRIPTION IN DETAIL AS TO HOW CORNER WAS LOCATED AND IDENTIFIED OR
RESTORED.

This corner was established, by proportionate measurement, by Forestry
Division survey crew, working in this Township. Burned over swamp, no positive
identification.

Corner was placed October 31, 1950.

SURVEYORS SEAL

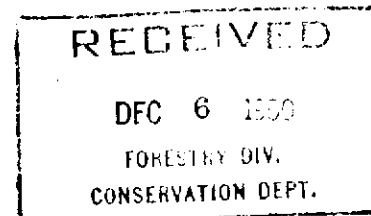

SIGNED John C. DeLo Mater DATE 12/1/50
REGISTERED LAND SURVEYOR