

MICHIGAN
DEPARTMENT OF CONSERVATION
FORESTRY DIVISION

LAND CORNER RECORD

T. 37. NR. 1. E.

_____ COUNTY

DESCRIPTION OF CORNER Section corner common to sections 5, 6, 7, 8

DESCRIPTION OF CORNER MONUMENT 1" Iron pipe with 4" Brass cap

WITNESSES TO CORNER ~~XXX~~


14" F. Pine - S 58 E - 32 Links

DESCRIPTION IN DETAIL AS TO HOW CORNER WAS LOCATED AND IDENTIFIED OR RESTORED.

Corner was established, by proportionate measurement, by Forestry Division Survey crew working in this Township. Remains of two probable B.T.'s, still in place, but badly burned.

Corner was placed October 19, 1950.

SURVEYORS SEAL

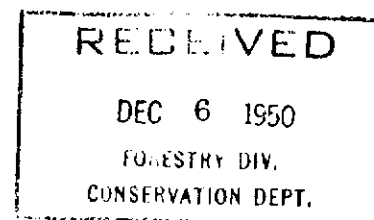

SIGNED Jean C. DeLaMater
REGISTERED LAND SURVEYOR

DATE 12/1/50