

MICHIGAN
DEPARTMENT OF CONSERVATION
FORESTRY DIVISION

LAND CORNER RECORD


T. 37 N.R. 1 E.
T. 37 N.R. 1 W. Cheboygan COUNTY

DESCRIPTION OF CORNER Set corner common to Sections 7 - 18 - 12 - 13

CORNER MONUMENT Set 1" pipe with 4" brass cap

DATE MONUMENT PLACED AND WITNESSED October 11, 1963

WITNESSES TO CORNER.....

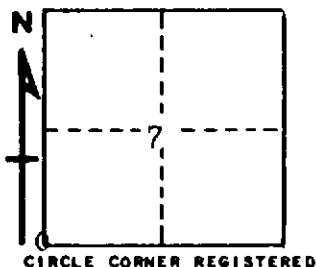

7" J. Pine N 15 W 19.6'

7" R. Pine S 68 W 31.1

AND 8" R. Pine S 15 E 20.2

DESCRIPTION IN DETAIL AS TO HOW CORNER WAS LOCATED AND IDENTIFIED OR RESTORED.

This corner was restored while making a survey in this area. Set corner at position prescribed by other corners along the meridian. Unable to locate a previous monument, but this point falls in line over 1/4 and section corner north and 1/4 and section corner south and at proper relative distance therefrom. Only place this corner could have been previously located but can find no evidence of previous corner.

SURVEYOR'S SEAL

SIGNED *Kenneth Ostling* DATE December 11, 1963
REGISTERED LAND SURVEYOR #10,068