

MICHIGAN  
DEPARTMENT OF CONSERVATION  
FORESTRY DIVISION

# LAND CORNER RECORD

T. 37 N.R. 1 E


Cheboygan COUNTY

DESCRIPTION OF CORNER Sec. corner common to sections 7, 8, 17 and 18

CORNER MONUMENT Set 1" pipe with 4" aluminum cap

DATE MONUMENT PLACED AND WITNESSED July 8, 1965

WITNESSES TO CORNER.....

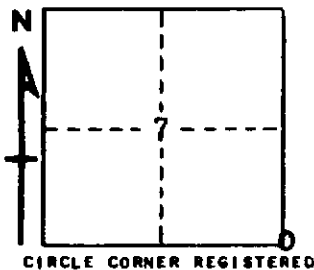

5" R Pine S 36 W 6.5'

5" J Pine N 34 W 10.7'

AND

DESCRIPTION IN DETAIL AS TO HOW CORNER WAS LOCATED AND IDENTIFIED OR RESTORED.

This corner was set by double proportionate measurement between section corners 1 mile north, south, east, and west while making a resurvey in this township. Unable to positively identify anything for U.S.evidence.

SURVEYOR'S SEAL

SIGNED *Kenneth J. Ostling* DATE October 18, 1965  
REGISTERED LAND SURVEYOR #10068