

MICHIGAN
DEPARTMENT OF CONSERVATION
FORESTRY DIVISION

LAND CORNER RECORD

T. 37 N.R. 1 E


Cheboygan COUNTY

DESCRIPTION OF CORNER 1/4 corner common to sections 6 and 7

CORNER MONUMENT Set 1" pipe with 4" aluminum cap

DATE MONUMENT PLACED AND WITNESSED July 9, 1965

WITNESSES TO CORNER.....

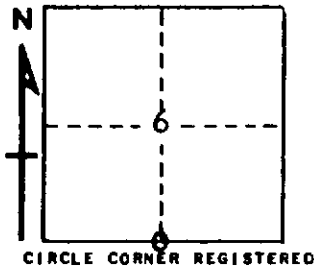

8" R. Oak N 40 W 22.3'

7" Maple N 61 E 26.0'

AND

DESCRIPTION IN DETAIL AS TO HOW CORNER WAS LOCATED AND IDENTIFIED OR RESTORED.

This corner was set by proportionate measurement between section corners while making a survey in this township. Nothing for USBT's or a previous corner.

SURVEYOR'S SEAL

SIGNED *Kenneth J. Osting* DATE October 18, 1965
REGISTERED LAND SURVEYOR # 10068