

✓

MICHIGAN
DEPARTMENT OF CONSERVATION
FORESTRY DIVISION

LAND CORNER RECORD

T. 37. NR. 1. E. . .

Cheboygan COUNTY

DESCRIPTION OF CORNER Section corner common to sections 20, 22, 32, 33

DESCRIPTION OF CORNER MONUMENT 2" Iron pipe

WITNESSES TO CORNER 4" F. Birch - N 12 F - 30 Links

10" Cedar - S 7" F - 12 Links


6" Cedar - S 25 F - 51 Links

DESCRIPTION IN DETAIL AS TO HOW CORNER WAS LOCATED AND IDENTIFIED OR RESTORED.

Corner was pointed out to me by District Forester A. Breidwood. Had been set by unknown Surveyor from original bearing trees. One original P.T. still in place.

Corner was re-witnessed October 16, 1950.

SURVEYORS SEAL

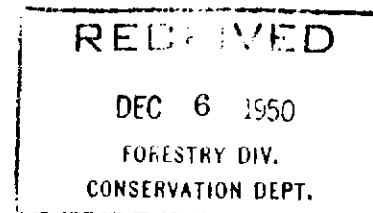

SIGNED

John C. DeLaMater
REGISTERED LAND SURVEYOR

DATE 12/4/50