

✓

MICHIGAN
DEPARTMENT OF CONSERVATION
FORESTRY DIVISION

LAND CORNER RECORD

T 37 NR 1 E
T 37 NR 1 E


DESCRIPTION OF CORNER Section corner common to sections 6,7,1,12 -----

DESCRIPTION OF CORNER MONUMENT 1" Iron pipe with 4" Brass cap -----

WITNESSES TO CORNER 10" Aspen - N 4 E - 92 Links -----

6" W. Birch - S 47 E - 59 Links -----


8" Red Oak - N 73 W - 1.24 chains -----

DESCRIPTION IN DETAIL AS TO HOW CORNER WAS LOCATED AND IDENTIFIED OR RESTORED.

This corner had been previously located by Marcus Schaaf, Registered Land Surveyor, from original B.T.'s. Replaced his iron pipe with our Forestry Division marker.

Corner placed October 19, 1950.

SURVEYORS SEAL

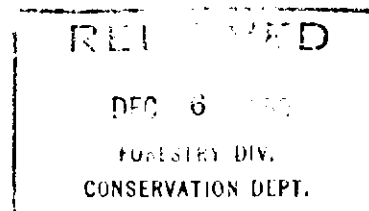

SIGNED

Jean C. DeLaMater
REGISTERED LAND SURVEYOR

DATE 12/14/50