

✓

MICHIGAN
DEPARTMENT OF CONSERVATION
FORESTRY DIVISION

LAND CORNER RECORD

T. 37. NR. 1. E. . .

. Cheboygan COUNTY

DESCRIPTION OF CORNER Section corner common to sections 16, 17, 20, 21

DESCRIPTION OF CORNER MONUMENT 1" Iron pipe with 4" Brass cap

WITNESSES TO CORNER 11" Aspen - S 60 E - 1.27 chains

12" Beech - N 2 E - 1.22 chains


10" S. 18" - S 60 E - 1.67 chains

DESCRIPTION IN DETAIL AS TO HOW CORNER WAS LOCATED AND IDENTIFIED OR RESTORED.

This corner was established, by proportionate measurement, by Forestry Division Survey crew working in this Township. Burned over land. No positive identification.

Corner was placed October 16, 1950.

SURVEYORS SEAL

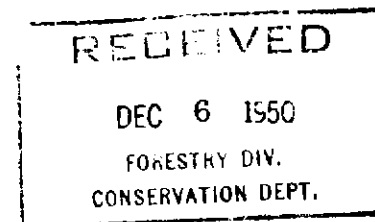

SIGNED Leah C. DeLoe DATE 12/4/50
REGISTERED LAND SURVEYOR