

MICHIGAN
DEPARTMENT OF CONSERVATION
FORESTRY DIVISION

LAND CORNER RECORD

T. 37 N.R. 1 E.


Cheboygan COUNTY

DESCRIPTION OF CORNER Section corner common to Sections 17 - 18 - 19 - 20

CORNER MONUMENT 1" pipe with 4" brass cap

DATE MONUMENT PLACED AND WITNESSED October 11, 1963

WITNESSES TO CORNER.....

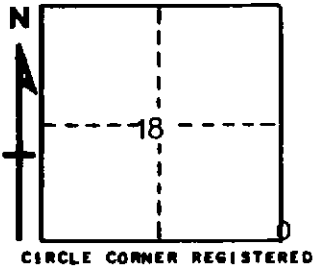

5" Cedar N 88 E 12.9'
8" Cedar S 61 W 12.6'
AND
6" Cedar N 34 W 10.9'

DESCRIPTION IN DETAIL AS TO HOW CORNER WAS LOCATED AND IDENTIFIED OR RESTORED.

This corner was set by single proportionate measurement between section corners, one mile east and one mile west, while making a survey in this township. Unable to identify anything definite for U. S. evidence.

SURVEYOR'S SEAL

SIGNED Kenneth Ostling DATE December 11, 1963
REGISTERED LAND SURVEYOR #10,068