

MICHIGAN  
DEPARTMENT OF CONSERVATION  
FORESTRY DIVISION

# LAND CORNER RECORD

T. 37 N. R. 1 E.


Cheboygan COUNTY

DESCRIPTION OF CORNER 1/4 corner common to Sections 19 - 20

CORNER MONUMENT Set 1" pipe with 4" aluminum cap

DATE MONUMENT PLACED AND WITNESSED December 10, 1963

WITNESSES TO CORNER.....

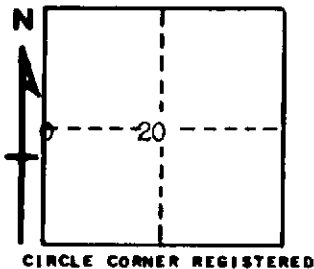

5" Maple N 19 E 14.3'

5" Ash S 47 W 11.2'

AND

DESCRIPTION IN DETAIL AS TO HOW CORNER WAS LOCATED AND IDENTIFIED OR RESTORED.

This corner was set by proportionate measurement, midpoint on line, between section corner. Cannot identify U. S. evidence or a previous corner.

SURVEYOR'S SEAL

SIGNED *Kenneth Ostling* DATE December 17, 1963  
REGISTERED LAND SURVEYOR #10,068