

MICHIGAN  
DEPARTMENT OF CONSERVATION  
FORESTRY DIVISION

# LAND CORNER RECORD

T. 37 N.R. 1 E.


Cheboygan COUNTY

DESCRIPTION OF CORNER 1/4 corner common to Sections 29 - 30

CORNER MONUMENT Set 1" pipe with 4" aluminum cap

DATE MONUMENT PLACED AND WITNESSED December 11, 1963

WITNESSES TO CORNER.....

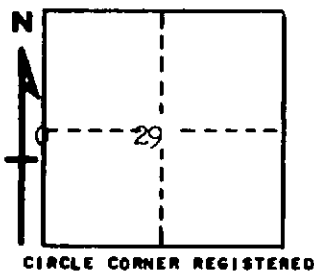

9" Cedar N 49 W 69.0'

7" R. Pine S 62 E 48.7

AND

DESCRIPTION IN DETAIL AS TO HOW CORNER WAS LOCATED AND IDENTIFIED OR RESTORED.

This corner was set by proportionate measurement, midpoint on line, between section corners while making a survey in this area. Nothing for a previous corner.

SURVEYOR'S SEAL

SIGNED *Kenneth H. Helling* DATE December 17, 1963  
REGISTERED LAND SURVEYOR #10,068