

MICHIGAN
DEPARTMENT OF CONSERVATION
FORESTRY DIVISION

LAND CORNER RECORD

T. 37 N.R. 1 E.


Cheboygan COUNTY

DESCRIPTION OF CORNER 1/4 corner common to Sections 25 - 36

CORNER MONUMENT Set 1" pipe with 4" aluminum cap

DATE MONUMENT PLACED AND WITNESSED December 11, 1963

WITNESSES TO CORNER.....

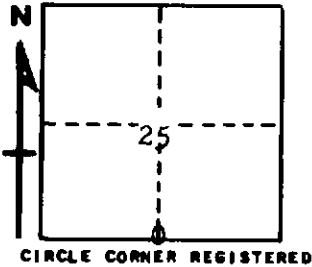

6" Cedar N 57 E 6.2'

7" Cedar N 75 W 3.9

AND

DESCRIPTION IN DETAIL AS TO HOW CORNER WAS LOCATED AND IDENTIFIED OR RESTORED.

This corner was found while making a survey in this area. Found 1 1/2" pipe at corner as previously established by unknown, set from U. S. BTs stumps, both cedar longbutts, with perfect faces and scribe marks, probably the best original evidence available in this area. Very good original corner.

SURVEYOR'S SEAL

SIGNED *Kenneth Ostling* DATE December 11, 1963
REGISTERED LAND SURVEYOR # 10,068