

MICHIGAN
DEPARTMENT OF CONSERVATION
FORESTRY DIVISION

LAND CORNER RECORD

T. 37 N. R. 1 E.


Cheboygan COUNTY

DESCRIPTION OF CORNER Section corner common to Sections 9 - 10 - 15 - 16

CORNER MONUMENT Set 1" pipe with 4" aluminum cap

DATE MONUMENT PLACED AND WITNESSED December 12, 1963

WITNESSES TO CORNER.....

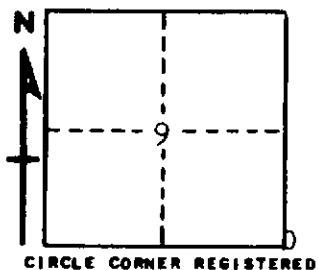

7" Balsam N 73 E 27.6'

12" H. Maple S 13 E 11.9

AND

DESCRIPTION IN DETAIL AS TO HOW CORNER WAS LOCATED AND IDENTIFIED OR RESTORED.

This corner was restored while making a survey in this area. Set corner from probable U. S. BT, a 36" W. Pine stump, and only one in vicinity. This point checks for measurement, and line to corners north and south and is considered quite definitely a restoration of the U. S. corner.

SURVEYOR'S SEAL

SIGNED *Kenneth J. Ostling* DATE December 17, 1963
REGISTERED LAND SURVEYOR #10,068