

LAND CORNER RECORDATION CERTIFICATE

Filing Requirement of Act 74, Mich. PA 1970

For Corners In: _____ Located In _____ Corner Code # _____
 Cheboygan (County)

1. Public Land Survey	T	37N	R	1E	C-3
	T	37N	R	1E	D-5
2. Property Controlling in Section	S	_____	R	_____	_____
	S	_____	R	_____	_____
3. Miscellaneous Property in Section	S	_____	R	_____	_____
	S	_____	R	_____	_____


4. Lot No: _____ Recorded Plat: _____

5. Private Claims: _____

I, Carl T. Kiiskila, in a field survey on October 30, 2001 do hereby state that under requirements of PA 74, Michigan PA of 1970, the corner points mentioned in lines 1 and 2 above were in conformance with regulations and rules therefore as required in the current manual of survey instructions of the United States Department of the Interior, Bureau of Land Management or by a decree of a Court of Law and/or that the corner points mentioned in lines 3, 4 and 5 above were in conformance with the rules of the Michigan Board of Land Surveyors or by a Decree of a Court of Law; established, re-established, monumented, recovered, found as expressed below:

NOTE: Not more than 2 corners, all in the same town and range, may be recorded on this certificate.

Register of Deeds Stamp & File Number

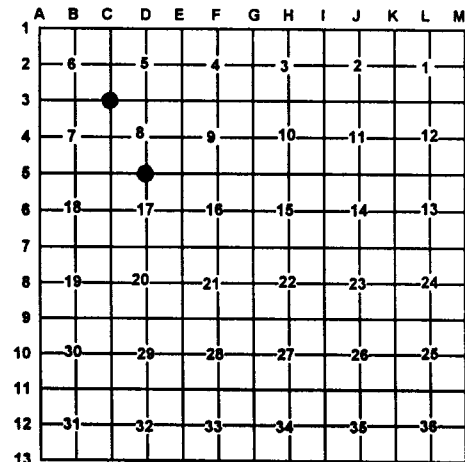

A. Description of original monument and accessories and/or subsequent restoration:

C-3 G.L.O. George H. Cannon DS 1854
 Set post corner of section 5,6,7 and 8
 Wit: Beech 14" East 26 links
 Beech 7" N54°W 12 links
 The Michigan Department of Conservation re-established this corner by proportionate measurement while doing a survey in the township in December of 1950.
 Wit: 14" W. Pine S58°E 32 links

D-5 G.L.O. George H. Cannon D.S. 1854
 Set quarter section post
 Wit: Yellow Pine 13 N57°E 20 links
 White Pine 15 S32°W 22 links
 The Michigan Department of Conservation re-established this corner by proportionate measurement between section corners while doing a survey in the township in October of 1965.
 Wit: 14" R. Pine N27°E 4.3'
 8" R. Pine S44°W 22.8'

B. Description of corner evidence found and/or method applies in restoring or re-establishing corner:

C-3 Found D.N.R. monument as set by the Michigan Department of Conservation while doing a survey in December 1950.

D-5 Found D.N. R. monument as set by the Michigan Department of Conservation while doing a survey in October of 1965.



C. Description of monument for corner and accessories established to perpetuate locating the position of the corner:

C-3 Found D.N.R. monument
 Wit: 4" White Pine East 24.52
 *6" White pine S25°E 10.12'
 3" Maple West 15.36'
 5" White Pine N22°W 12.46'
 Carsonite post North 1'±

D-5 Found D.N.R. monument
 Wit: *14" Red Pine N29°E 4.92'
 *10" Red Pine S29°W 1.60'
 4" Red Pine S65°E 17.71'
 20" Red Pine N80°W 41.31'

* Old witnesses by others

* Old witnesses by others

Signed by: Carl T Kiiskila
 Surveyor's Michigan License No.: 33981

Date: 2-20-02