

LAND CORNER RECORDATION CERTIFICATE

Filing Requirement of Act 74, Mich. PA 1970

For Corners In: Cheboygan (County)	Located In	Corner Code #
1. Public Land Survey	T <u>37N</u> R <u>1E</u>	<u>D-3</u>
	T <u>37N</u> R <u>1E</u>	<u>E-7</u>
2. Property Controlling in Section	S _____ T _____ R _____	_____
	S _____ T _____ R _____	_____
3. Miscellaneous Property in Section	S _____ T _____ R _____	_____
	S _____ T _____ R _____	_____


Register of Deeds Stamp & File Number

4. Lot No: _____ Recorded Plat: _____

5. Private Claims: _____

I, Carl T. Kiiskila, in a field survey on December 20, 2001 do hereby state that under requirements of PA 74, Michigan PA of 1970, the corner points mentioned in lines 1 and 2 above were in conformance with regulations and rules therefore as required in the current manual of survey instructions of the United States Department of the Interior, Bureau of Land Management or by a decree of a Court of Law and/or that the corner points mentioned in lines 3, 4 and 5 above were in conformance with the rules of the Michigan Board of Land Surveyors or by a Decree of a Court of Law; established, re-established, monumented, recovered, found as expressed below:

NOTE: Not more than 2 corners, all in the same town and range, may be recorded on this certificate.

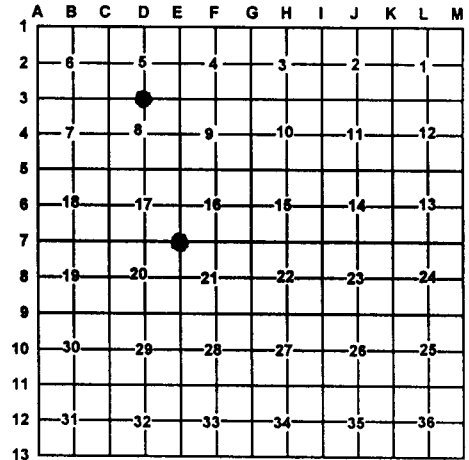

A. Description of original monument and accessories and/or subsequent restoration:

D-3 G.L.O. George H. Cannon D.S. 1854
Set quarter section post
Wit: Beech 12" N14°W 54 links
Beech 20" South 25 links

E-7 G.L.O. George H. Cannon D.S. 1854
Set post corner of section 16, 17, 20 and 21
Wit: Beech 14" N85°E 2.5 links
Beech 12" S55°W 36 links


The Michigan Department of Conservation re-established this corner by proportionate measurement while doing a survey in December of 1950.

Wit: 11" Aspen S60°E 1.27 chains
12" Beech N30°E 1.09 chains
10" R. Oak S06°E 1.67 chains

B. Description of corner evidence found and/or method applies in restoring or re-establishing corner:

D-3 Found 1" pipe probably set by the Michigan Department of Conservation during a survey in 1963. This corner fits a single proportionate measurement position between corners to the East and West.

E-7 Re-established the Southeast corner of section 17 from one of the Department of Conservation bearing trees and two of the Department of conservation bearing tree stumps.

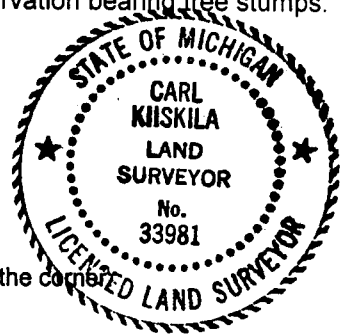

C. Description of monument for corner and accessories established to perpetuate locating the position of the corner:

D-3 Found 1" pipe set P.S. cap #33981
Wit: 8" Maple N66°E 2.88'
5" Ironwood S52°E 35.28'
4" Maple S54°W 35.03'
10" Twin Maple N24°W 41.04'
N-S two track West 13'
Carsonite post North 1'

E-7 Set D.N.R. monument
Wit: 8" Maple N36°W 20.68'
8" Maple N01°W 35.37'
20" Beech N03°E 73.27'
7" Maple N34°E 40.49'
5" Maple N72°E 72.44'
24" Aspen stump S55°E 83.4'
Carsonite post North 1'

Signed by: Carl T Kiiskila

Date: 2-20-02

Surveyor's Michigan License No.: 33981