

**SURVEY &  
REMONUMENTATION**

MAY 03 1995

CHEBOYGAN COUNTY REMONUMENTATION CORNER  
**LAND CORNER RECORDATION CERTIFICATE**  
Filing Requirement of Act 74, Mich. P.A. 1970

RECEIVED  
FOR RECORD

94 NOV 22 AM 10:17

*James Gray*  
CLERK/REGISTER  
CHEBOYGAN COUNTY, MICHIGAN

For corners in **COMMISSION**

CHEBOYGAN (County)	Located In:	Corner Code #
1. Public Land Survey	T <u>37</u> N R <u>1</u> W	<u>A-1</u>
	T _____ R _____	_____
	T _____ R _____	_____
	T _____ R _____	_____
2. Property Controlling in Section	S _____ T _____ R _____	_____
	S _____ T _____ R _____	_____
3. Miscellaneous Property in Sec.	S _____ T _____ R _____	_____
	S _____ T _____ R _____	_____

Register of Deeds Stamp & File Number

4. Lot No. \_\_\_\_\_, Recorded Plat \_\_\_\_\_  
5. Private Claims \_\_\_\_\_


	A	B	C	D	E	F	G	H	I	J	K	L	M
2	6	5	4	3	2	1							
3													
4	7	8	9	10	11	12							
5													
6	18	17	16	15	14	13							
7													
8	19	20	21	22	23	24							
9													
10	30	29	28	27	26	25							
11													
12	31	32	33	34	35	36							
13													

I, Ronald Bischer, in a field survey on July 6, 19 94, do hereby certify that under requirements of P.A. 74, Michigan P.A. of 1970, the corner points mentioned in lines 1 and 2 above were in conformance with regulations and rules therefore as required in the current manual of survey instructions of the United States Department of the Interior, Bureau of Land Management or by a decree of a Court of Law and/or that the corner points mentioned in lines 3, 4 and 5 above were in conformance with the rules of the Michigan Board of Land Surveyors or by a Decree of a Court of Law; established, re-established, monumented, re-monumented, recovered, found as expressed below:

**NOTE: Not more than 4 corners, all in the same town and range, may be recorded on this certificate.**

**A. Description of original monument and accessories and/or subsequent restoration:**

1840 GLO Survey - John Mullett	SE 84.40' Fire Hydrant
Set Wood Post	10-29-91 - James H. Granger
Fir 12" N45°W 24 links	Set Rebar w/cap #16041
Cedar 10" S80°E 29 links	S55°W 36.85' Power pole
03-02-64 - Kenneth R. Larsen	N33°W 39.04' Power pole
Found Iron	N75°E 53.36' R.R. Xing sign
NW 39.32' Power pole	S72°E 145.32' Power pole
NE 32.65' Power pole	
SW 33.89' Power pole	

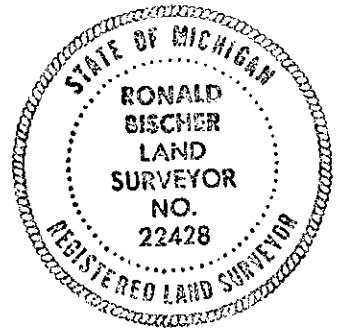

**B. Description of corner evidence found and/or method applied in restoring or reestablishing corner:**

1/2" Rebar w/cap #16041  
S55°W 36.85' Power pole  
N33°W 39.04' Power pole  
S72°E 145.32' Power pole


Replaced 1/2" Rebar with Cheboygan County Remonumentation Monument.

**C. Description of monument for corner and accessories established to perpetuate locating the position of the corner:**

Cheboygan County Remonumentation Monument  
S55°W 36.85' Power pole  
N33°W 39.04' Power pole  
S72°E 145.32' Power pole  
N61°E 76.40' Michigan Bell Post

LIBER 010 PAGE 67

*Morris J. Ross*

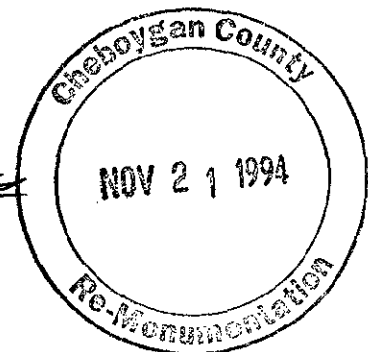

igned by Ronald R. Bischer Date Oct 25, 1994

urveyor's Michigan License No. 22428