

**SURVEY & REMONUMENTATION**

CHEBOYGAN COUNTY REMONUMENTATION CORNER

RECEIVED FOR RECORD

MAY 03 1995

LAND CORNER RECORDATION CERTIFICATE

94 NOV 22 AM 10:18

Filing Requirement of Act 74, Mich. P.A. 1970

COMMISSION

*James H. Granger*  
CLERK/REGISTER  
CHEBOYGAN COUNTY, MICHIGAN

For corners in

CHEBOYGAN  
(County)

Located In:

Corner Code #

- |                                    |   |            |   |           |            |
|------------------------------------|---|------------|---|-----------|------------|
| 1. Public Land Survey              | T | <u>37N</u> | R | <u>1W</u> | <u>A-2</u> |
|                                    | T | _____      | R | _____     | _____      |
|                                    | T | _____      | R | _____     | _____      |
|                                    | T | _____      | R | _____     | _____      |
| 2. Property Controlling in Section | S | _____      | T | _____     | _____      |
|                                    | S | _____      | T | _____     | _____      |
| 3. Miscellaneous Property in Sec.  | S | _____      | T | _____     | _____      |
|                                    | S | _____      | T | _____     | _____      |
4. Lot No. \_\_\_\_\_, Recorded Plat \_\_\_\_\_
5. Private Claims \_\_\_\_\_

Register of Deeds Stamp & File Number


	A	B	C	D	E	F	G	H	I	J	K	L	M
2	6	5	4	3	2	1							
3													
4	7	8	9	10	11	12							
5													
6	18	17	16	15	14	13							
7													
8	19	20	21	22	23	24							
9													
10	30	29	28	27	26	25							
11													
12	31	32	33	34	35	36							
13													

I, Ronald Bischer, in a field survey on July 6, 19 94, do hereby certify that under requirements of P.A. 74, Michigan P.A. of 1970, the corner points mentioned in lines 1 and 2 above were in conformance with regulations and rules therefore as required in the current manual of survey instructions of the United States Department of the Interior, Bureau of Land Management or by a decree of a Court of Law and/or that the corner points mentioned in lines 3, 4 and 5 above were in conformance with the rules of the Michigan Board of Land Surveyors or by a Decree of a Court of Law; established, re-established, monumented, re-monumented, recovered, found as expressed below:

**NOTE: Not more than 4 corners, all in the same town and range, may be recorded on this certificate.**

A. Description of original monument and accessories and/or subsequent restoration:

- June 1840 GLO Survey - John Mullett      02-03-93 - James H. Granger  
Set Wood Post      Same as 08-26-91 - James H. Granger
- B. Ash 10" N72°E 7 links
- 08-26-91 - James H. Granger  
Found 3/4" Pipe in Monument box  
S32°E 54.64' Fence Post  
N84°W 24.39' Fence Post  
N35°W 36.61' Fence Post  
N54°E 31.70' Sign Post

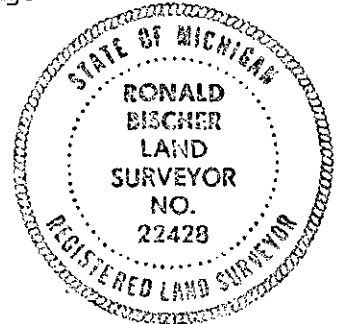

B. Description of corner evidence found and/or method applied in restoring or reestablishing corner:


- 3/4" Pipe in Monument Box  
S32°E 54.64' Fence Post  
N84°W 24.60' Fence Post  
N35°W 36.61' Fence Post  
N54°E 30.90' Sign Post
- Replaced 3/4" Pipe with Cheboygan County Remonumentation Monument in Monument Box.

C. Description of monument for corner and accessories established to perpetuate locating the position of the corner:

- Cheboygan County Remonumentation Monument in Monument Box  
S32°E 54.64' Fence Post  
N84°W 24.60' Fence Post  
N35°W 36.61' Fence Post  
N54°E 30.90' Sign Post

LIBER 010 PAGE 68

*Marcus D. Papp*

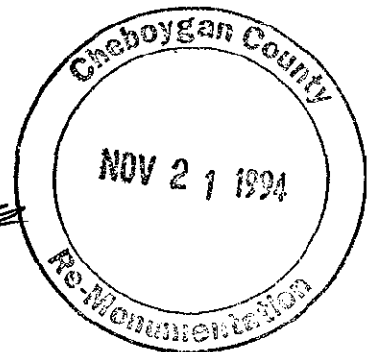

Signed by Ronald R. Bischer

Date Oct 25, 1994

Surveyor's Michigan License No. 22428