

SURVEY & REMONUMENTATION

CHEBOYGAN COUNTY REMONUMENTATION CORNER

MAY 03 1995

LAND CORNER RECORDATION CERTIFICATE
Filing Requirement of Act 74, Mich. P.A. 1970

RECEIVED FOR RECORD

94 NOV 22 AM 10:20

Joanna Spray
CLERK/REGISTER
CHEBOYGAN COUNTY, MICHIGAN

Register of Deeds Stamp & File Number

For corners in **COMMISSION**

CHEBOYGAN (County)	Located In:	Corner Code #
1. Public Land Survey	T <u>37N</u> R <u>1W</u>	<u>A-3</u>
	T _____ R _____	_____
	T _____ R _____	_____
	T _____ R _____	_____
2. Property Controlling in Section	S _____ T _____ R _____	_____
	S _____ T _____ R _____	_____
3. Miscellaneous Property in Sec.	S _____ T _____ R _____	_____
	S _____ T _____ R _____	_____
4. Lot No. _____, Recorded Plat _____		
5. Private Claims _____		

	A	B	C	D	E	F	G	H	I	J	K	L	M
2	6	5	4	3	2	1							
3	7	8	9	10	11	12							
4													
5													
6	18	17	16	15	14	13							
7													
8	19	20	21	22	23	24							
9													
10	30	29	28	27	26	25							
11													
12	31	32	33	34	35	36							
13													

I, Ronald Bischer, in a field survey on July 6, 1994, do hereby certify that under requirements of P.A. 74, Michigan P.A. of 1970, the corner points mentioned in lines 1 and 2 above were in conformance with regulations and rules therefore as required in the current manual of survey instructions of the United States Department of the Interior, Bureau of Land Management or by a decree of a Court of Law and/or that the corner points mentioned in lines 3, 4 and 5 above were in conformance with the rules of the Michigan Board of Land Surveyors or by a Decree of a Court of Law; established, re-established, monumented, re-monumented, recovered, found as expressed below:

NOTE: Not more than 4 corners, all in the same town and range, may be recorded on this certificate.

A. Description of original monument and accessories and/or subsequent restoration:

- June 1840 GLO Survey - John Mullett
Set Wood Post
Pine 16" N27°E 21 links
Maple 14" S76°W 16 links
- 02-10-76 - Delmar E. Porter
Fd. Pk Nail (Co Rd. Comm. plans)
West 40.00' Concrete Monument
East 40.00' Hubb
S83°E 41.96' Power pole
- 07-15-91 - James H. Granger
Pk Nail
West 40.00' Concrete monument
S83°E 41.96' Power pole
N41°W 56.02' Fence Post
S17°W 211.29' 1/2" Rebar w/cap #16041
- 08-15-91 - James H. Granger
same as 07-15-91 - James H. Granger
- 02-03-93 - James H. Granger - same as above

B. Description of corner evidence found and/or method applied in restoring or reestablishing corner:

- Pk Nail
S83°E 41.96' Power pole
West 40.00' Concrete monument
N41°W 56.02' Fence post
S17°W 211.29' 1/2" Rebar w/cap #16041
- Replaced Pk Nail with Cheboygan County Remonumentation Monument.




C. Description of monument for corner and accessories established to perpetuate locating the position of the corner:

- Cheboygan County Remonumentation Monument
S83°E 41.96' Power pole
West 40.00' Concrete Monument
N41°W 56.02' Fence Post
S17°W 211.29' 1/2" Rebar w/cap #16041

LIBER 010 PAGE 69

Martin A. Papp

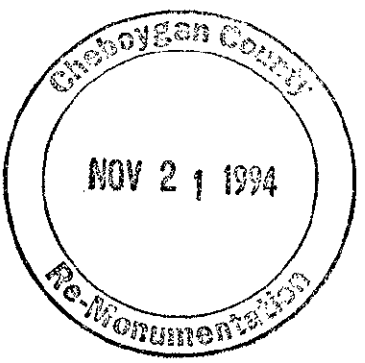

Signed by Ronald R. Bischer

Date Oct 25, 1994

Surveyor's Michigan License No. 22428