

**SURVEY & REMONUMENTATION**  
CHEBOYGAN COUNTY REMONUMENTATION CORNER

MAY 03 1995

**LAND CORNER RECORDATION CERTIFICATE**  
Filing Requirement of Act 74, Mich. P.A. 1970

RECEIVED  
FOR RECORD

94 NOV 22 AM 10:22

*Joanna Spray*  
CLERK/REGISTER  
CHEBOYGAN COUNTY, MICHIGAN

For corners in **CHEBOYGAN** COMMISSION

CHEBOYGAN  
(County)

Located In:

Corner Code ##

- |                                    |   |            |   |           |            |
|------------------------------------|---|------------|---|-----------|------------|
| 1. Public Land Survey              | T | <u>37N</u> | R | <u>1W</u> | <u>A-5</u> |
|                                    | T | _____      | R | _____     | _____      |
|                                    | T | _____      | R | _____     | _____      |
|                                    | T | _____      | R | _____     | _____      |
| 2. Property Controlling in Section | S | _____      | T | _____     | R          |
|                                    | S | _____      | T | _____     | R          |
| 3. Miscellaneous Property in Sec.  | S | _____      | T | _____     | R          |
|                                    | S | _____      | T | _____     | R          |

Register of Deeds Stamp & File Number

4. Lot No. \_\_\_\_\_, Recorded Plat \_\_\_\_\_  
5. Private Claims \_\_\_\_\_

|    | A  | B  | C  | D  | E  | F  | G | H | I | J | K | L | M |
|----|----|----|----|----|----|----|---|---|---|---|---|---|---|
| 2  | 6  | 5  | 4  | 3  | 2  | 1  |   |   |   |   |   |   |   |
| 3  |    |    |    |    |    |    |   |   |   |   |   |   |   |
| 4  | 7  | 8  | 9  | 10 | 11 | 12 |   |   |   |   |   |   |   |
| 5  |    |    |    |    |    |    |   |   |   |   |   |   |   |
| 6  | 18 | 17 | 16 | 15 | 14 | 13 |   |   |   |   |   |   |   |
| 7  |    |    |    |    |    |    |   |   |   |   |   |   |   |
| 8  | 19 | 20 | 21 | 22 | 23 | 24 |   |   |   |   |   |   |   |
| 9  |    |    |    |    |    |    |   |   |   |   |   |   |   |
| 10 | 30 | 29 | 28 | 27 | 26 | 25 |   |   |   |   |   |   |   |
| 11 |    |    |    |    |    |    |   |   |   |   |   |   |   |
| 12 | 31 | 32 | 33 | 34 | 35 | 36 |   |   |   |   |   |   |   |
| 13 |    |    |    |    |    |    |   |   |   |   |   |   |   |

I, Ronald Bischer, in a field survey on July 6, 1994, do hereby certify that under requirements of P.A. 74, Michigan P.A. of 1970, the corner points mentioned in lines 1 and 2 above were in conformance with regulations and rules therefore as required in the current manual of survey instructions of the United States Department of the Interior, Bureau of Land Management or by a decree of a Court of Law and/or that the corner points mentioned in lines 3, 4 and 5 above were in conformance with the rules of the Michigan Board of Land Surveyors or by a Decree of a Court of Law; established, re-established, monumented, re-monumented, recovered, found as expressed below:

**NOTE: Not more than 4 corners, all in the same town and range, may be recorded on this certificate.**


**A. Description of original monument and accessories and/or subsequent restoration:**

|  |  |  |
|--|--|--|
| June 1840 GLO Survey - John Mullett<br>Set Wood Post | 02-10-76 - Delmar E. Porter<br>Found 1/2" Pipe in Mon. Box | S34°E 57.19' Fence Post<br>S52°W 65.36' Power pole |
| Cedar 12" S40°W 38 links                             | N55°W 48.96' Power pole                                    | 12-28-90 - James H. Granger                        |
| Sugar 10" N22°E 18 links                             | N87°E 48.93' Utility pole                                  | Found 1/2" Pipe in Mon. Box                        |
| April 1957 - Orlando Doyle                           | S53°W 66.62' Power pole                                    | N87°E 48.93' Utility pole                          |
| Found bolt inside 1 1/2" Pipe                        | 05-01-88 - James H. Granger                                | S52°W 66.62' Power pole                            |
| N78°30'W 90.01' 8" Cedar                             | Found 3/4" Pipe in Mon. Box                                | N42°W 38.29' 1/2" Iron                             |
| S49°30'W 50.01' 8" Cedar                             | S87°E 48.96' Power pole                                    | S42°E 26.00' 1/2" Iron                             |
| S30°W 73.58' 16" W. Ash                              | S75°E 41.27' 5" Ash  |  |

**B. Description of corner evidence found and/or method applied in restoring or reestablishing corner:**

1/2" Pipe in Monument Box  
N84°E 48.96' Power pole  
S86°E 41.19' 5" Ash  
S42°E 57.19' Fence post  
S52°W 65.36' Power pole

Replaced 1/2" Pipe with Cheboygan County Remonumentation Monument in Monument Box.

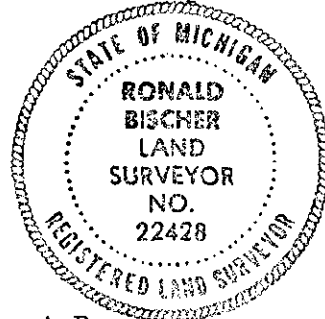


**C. Description of monument for corner and accessories established to perpetuate locating the position of the corner:**

Cheboygan County Remonumentation Monument in Monument Box  
N84°E 48.96' Power pole  
S86°E 41.19' 5" Ash  
S42°E 57.19' Fence post  
S52°W 65.36' Power pole

LIBER 010 PAGE 71

*Marius A. Rose*

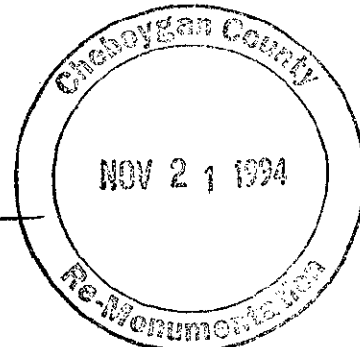

Signed by Ronald R. Bischer

Date Oct. 25, 1994

Surveyor's Michigan License No. 22428