

**SURVEY & REMONUMENTATION**  
CHEBOYGAN COUNTY REMONUMENTATION CORNER

MAY 03 1995 **LAND CORNER RECORDATION CERTIFICATE**  
Filing Requirement of Act 74, Mich. P.A. 1970

RECEIVED FOR RECORD  
94 NOV 22 AM 10:29

*Jeanne Spray*  
CLERK/REGISTER  
CHEBOYGAN COUNTY, MICHIGAN

For corners in

**COMMISSION**

<u>CHEBOYGAN</u> (County)	Located In:	Corner Code #
1. Public Land Survey	T <u>37N</u> R <u>1W</u>	<u>B-7</u>
	T _____ R _____	_____
	T _____ R _____	_____
	T _____ R _____	_____
2. Property Controlling in Section	S _____ T _____ R _____	_____
	S _____ T _____ R _____	_____
3. Miscellaneous Property in Sec.	S _____ T _____ R _____	_____
	S _____ T _____ R _____	_____

Register of Deeds Stamp & File Number

4. Lot No. \_\_\_\_\_, Recorded Plat \_\_\_\_\_  
5. Private Claims \_\_\_\_\_

	A	B	C	D	E	F	G	H	I	J	K	L	M
2	6	5	4	3	2	1							
3													
4	7	8	9	10	11	12							
5													
6	18	17	16	15	14	13							
7	●												
8	19	20	21	22	23	24							
9													
10	30	29	28	27	26	25							
11													
12	31	32	33	34	35	36							
13													

I, Ronald Bischer, in a field survey on September 20, 19 94, do hereby certify that under requirements of P.A. 74, Michigan P.A. of 1970, the corner points mentioned in lines 1 and 2 above were in conformance with regulations and rules therefore as required in the current manual of survey instructions of the United States Department of the Interior, Bureau of Land Management or by a decree of a Court of Law and/or that the corner points mentioned in lines 3, 4 and 5 above were in conformance with the rules of the Michigan Board of Land Surveyors or by a Decree of a Court of Law; established, re-established, monumented, re-monumented, recovered, found as expressed below:

**NOTE: Not more than 4 corners, all in the same town and range, may be recorded on this certificate.**

A. Description of original monument and accessories and/or subsequent restoration:

May 1856 - GLO Resurvey Notes  
Set Wood Post  
Sugar 12" N35°E 19 links  
Cedar 12" S78°E 36 links


January 1964 - Kenneth R. Larsen  
1" Axle  
Same witnesses as above.

July 1962 - M. Koivisto  
Found 1" Axle shaft  
N50°W 57.63' 45" Triple Elm  
S70°E 15.34' Power pole  
N55°E 38.07' 16" Twin Apple

B. Description of corner evidence found and/or method applied in restoring or reestablishing corner:

1" Axle  
S62°E 15.34' Power pole  
South 30.89' 18" Willow

Replaced 1" Axle with Cheboygan County Remonumentation Monument.

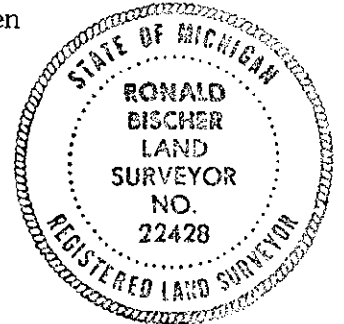

C. Description of monument for corner and accessories established to perpetuate locating the position of the corner:

Cheboygan County Remonumentation Monument  
South 30.89' 18" Willow  
S50°W 35.55' Power pole  
S62°E 15.34' Power pole  
N71°E 28.29' 8" Twin Apple

LIBER **010** PAGE **78**

*Marcus A. Ross*



igned by Ronald R. Bischer Date Oct 25, 1994  
urveyor's Michigan License No. 22428