

**SURVEY & REMONUMENTATION**

CHEBOYGAN COUNTY REMONUMENTATION CORNER

**LAND CORNER RECORDATION CERTIFICATE**

Filing Requirement of Act 74, Mich. P.A. 1970

MAY 03 1995

RECEIVED FOR RECORD

94 NOV 22 AM 10:30

*James Gray*  
CLERK/REGISTER  
CHEBOYGAN COUNTY, MICHIGAN

Register of Deeds Stamp & File Number

For corners in

CHEBOYGAN  
(County)

COMMISSION

Located In:

Corner Code #

1. Public Land Survey	T	<u>37N</u>	R	<u>1W</u>	<u>B-9</u>
	T	_____	R	_____	_____
	T	_____	R	_____	_____
	T	_____	R	_____	_____
2. Property Controlling in Section	S	_____	T	_____	R
	S	_____	T	_____	R
3. Miscellaneous Property in Sec.	S	_____	T	_____	R
	S	_____	T	_____	R

4. Lot No. \_\_\_\_\_, Recorded Plat \_\_\_\_\_  
5. Private Claims \_\_\_\_\_

I, Ronald Bischer, in a field survey on July 7, 1994, do hereby certify that under requirements of P.A. 74, Michigan P.A. of 1970, the corner points mentioned in lines 1 and 2 above were in conformance with regulations and rules therefore as required in the current manual of survey instructions of the United States Department of the Interior, Bureau of Land Management or by a decree of a Court of Law and/or that the corner points mentioned in lines 3, 4 and 5 above were in conformance with the rules of the Michigan Board of Land Surveyors or by a Decree of a Court of Law; established, re-established, monumented, re-monumented, recovered, found as expressed below:


**NOTE: Not more than 4 corners, all in the same town and range, may be recorded on this certificate.**

	A	B	C	D	E	F	G	H	I	J	K	L	M
2	6	5	4	3	2	1							
3													
4	7	8	9	10	11	12							
5													
6	18	17	16	15	14	13							
7													
8	19	20	21	22	23	24							
9	●												
10	30	29	28	27	26	25							
11													
12	31	32	33	34	35	36							
13													

**A. Description of original monument and accessories and/or subsequent restoration:**

May 1856 GLO Resurvey Notes  
Set Wood Post  
B. Ash 9" N72°E 105 links  
No other witness available.  
10-11-91 - James H. Granger  
Found 1" Rod  
N32°W 44.90' Power pole  
S50°W 39.85' Power pole

S26°E 35.47' Power pole  
N54°E 84.86' 10" Poplar  
11-18-91 - James H. Granger  
1" Rod  
witnesses same as above

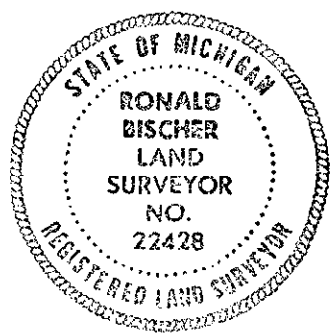

**B. Description of corner evidence found and/or method applied in restoring or reestablishing corner:**


1" Rod  
S29°E 35.49' Power pole  
N35°W 44.85' Power pole  
S46°W 39.85' Anchor pole  
N53°E 84.86' 10" Aspen  
Replaced 1" Rod with Cheboygan County Remonumentation Monument.

**C. Description of monument for corner and accessories established to perpetuate locating the position of the corner:**

Cheboygan County Remonumentation Monument  
S29°E 35.49' Power pole  
N35°W 44.85' Power pole  
S46°W 39.85' Anchor pole  
N53°E 84.86' 10" Aspen

LIBER 010 PAGE 79

*Maurice A. Ross*

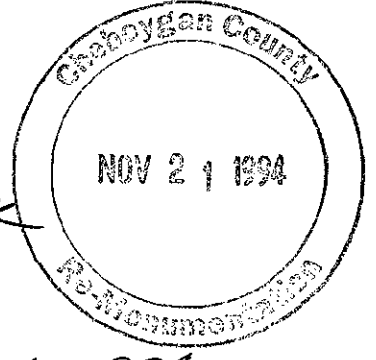

Signed by Ronald R. Bischer Date Oct. 25, 1994

Surveyor's Michigan License No. 22428