

**SURVEY & REMONUMENTATION**  
CHEBOYGAN COUNTY REMONUMENTATION CORNER

RECEIVED  
FOR RECORD

MAY 03 1995  
**LAND CORNER RECORDATION CERTIFICATE**  
Filing Requirement of Act 74, Mich. P.A. 1970

94 NOV 22 AM 10:36

For corners in  
CHEBOYGAN  
(County)

**COMMISSION**  
Located In:

Corner Code #

*James Spray*  
CLERK/REGISTER  
CHEBOYGAN COUNTY, MICHIGAN

1. Public Land Survey	T	<u>37N</u>	R	<u>1W</u>	<u>C-5</u>
	T	_____	R	_____	_____
	T	_____	R	_____	_____
	T	_____	R	_____	_____
2. Property Controlling in Section	S	_____	T	_____	_____
	S	_____	T	_____	_____
3. Miscellaneous Property in Sec.	S	_____	T	_____	_____
	S	_____	T	_____	_____

Register of Deeds Stamp & File Number

4. Lot No. \_\_\_\_\_, Recorded Plat \_\_\_\_\_  
5. Private Claims \_\_\_\_\_

A	B	C	D	E	F	G	H	I	J	K	L	M
2	6	5	4	3	2	1						
3												
4	7	8	9	10	11	12						
5												
6	18	17	16	15	14	13						
7												
8	19	20	21	22	23	24						
9												
10	30	29	28	27	26	25						
11												
12	31	32	33	34	35	36						
13												

I, Ronald Bischer, in a field survey on September 16, 19 94, do hereby certify that under requirements of P.A. 74, Michigan P.A. of 1970, the corner points mentioned in lines 1 and 2 above were in conformance with regulations and rules therefore as required in the current manual of survey instructions of the United States Department of the Interior, Bureau of Land Management or by a decree of a Court of Law and/or that the corner points mentioned in lines 3, 4 and 5 above were in conformance with the rules of the Michigan Board of Land Surveyors or by a Decree of a Court of Law; established, re-established, monumented, re-monumented, recovered, found as expressed below:

**NOTE: Not more than 4 corners, all in the same town and range, may be recorded on this certificate.**


**A. Description of original monument and accessories and/or subsequent restoration:**

May 1856 GLO Resurvey Notes	3/4" Pipe	S32°E 53.13'	Top of Guard Rail
Set Wood Post	Witnesses same as above		post
Sugar 18" S45°W 31 links	01-18-76 - Delmar E. Porter	N21°W 46.15'	" "
Sugar 16" N85°E 35 links	3/4" Pipe raised w/bolt	S63°W 34.42'	" "
July 1962 - M. Koivisto	witnesses same as in 1962	S32°E 53.13'	36" Poplar
Found 3/4" Pipe	02-10-76 - Delmar E. Porter	06-28-89 - James H. Granger	5/8" Rod
S50°E 52.84' 30" Poplar	3/4" Pipe raised w/bolt		witnesses same as above
S70°E 69.57' 24" Elm	witnesses same as in 1962		
N80°E 47.35' Power pole	06-01-88 - James H. Granger		
January 1964 - Kenneth R. Larsen	Found 5/8" Iron Rod		

**B. Description of corner evidence found and/or method applied in restoring or reestablishing corner:**

5/8" Bolt with head up.  
S45°E 53.13' 40" Poplar  
N62°E 23.04' Top of guard rail post  
S81°W 26.60' Top of guard rail post  
N32°W 46.60' Top of guard rail post


Replaced Bolt with Cheboygan County Remonumentation Monument.

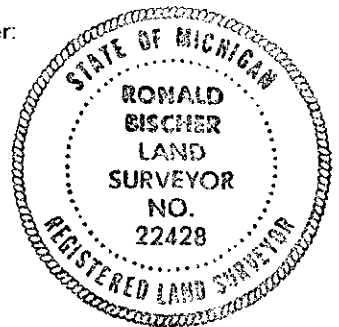

**C. Description of monument for corner and accessories established to perpetuate locating the position of the corner:**

Cheboygan County Remonumentation Monument  
S45°E 53.13' 40" Poplar  
N62°E 23.04' Top of guard rail post  
S81°W 26.60' Top of guard rail post  
N32°W 46.60' Top of guard rail post

LIBER 010 PAGE 80

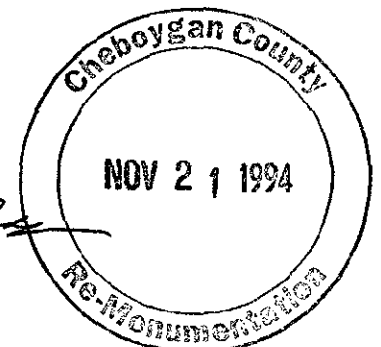

*Monica A. Post*

Signed by Ronald R. Bischer Date Oct 25, 1994  
Surveyor's Michigan License No. 22428