

**SURVEY &
REMONUMENTATION**

CHEBOYGAN COUNTY REMONUMENTATION CORNER

MAY 03 1994 LAND CORNER RECORDATION CERTIFICATE

Filing Requirement of Act 74, Mich. P.A. 1970

COMMISSION

RECEIVED
FOR RECORD

94 NOV 22 AM 10:37

James Spray
CLERK/REGISTER
CHEBOYGAN COUNTY, MICHIGAN

For corners in

CHEBOYGAN
(County)

Located In:

Corner Code #

- | | | |
|------------------------------------|--------------------------|------------|
| 1. Public Land Survey | T <u>37N</u> R <u>1W</u> | <u>C-6</u> |
| | T _____ R _____ | _____ |
| | T _____ R _____ | _____ |
| | T _____ R _____ | _____ |
| 2. Property Controlling in Section | S _____ T _____ R _____ | _____ |
| | S _____ T _____ R _____ | _____ |
| 3. Miscellaneous Property in Sec. | S _____ T _____ R _____ | _____ |
| | S _____ T _____ R _____ | _____ |

Register of Deeds Stamp & File Number

4. Lot No. _____, Recorded Plat _____
5. Private Claims _____

	A	B	C	D	E	F	G	H	I	J	K	L	M
2	6		5		4		3		2		1		
3													
4	7		8		9		10		11		12		
5													
6	18		17		16		15		14		13		
7													
8	19		20		21		22		23		24		
9													
10	30		29		28		27		26		25		
11													
12	31		32		33		34		35		36		
13													

I, Ronald Bischer, in a field survey on July 8, 19 94, do hereby certify that under requirements of P.A. 74, Michigan P.A. of 1970, the corner points mentioned in lines 1 and 2 above were in conformance with regulations and rules therefore as required in the current manual of survey instructions of the United States Department of the Interior, Bureau of Land Management or by a decree of a Court of Law and/or that the corner points mentioned in lines 3, 4 and 5 above were in conformance with the rules of the Michigan Board of Land Surveyors or by a Decree of a Court of Law; established, re-established, monumented, re-monumented, recovered, found as expressed below:

NOTE: Not more than 4 corners, all in the same town and range, may be recorded on this certificate.

A. Description of original monument and accessories and/or subsequent restoration:

May 1856 GLO Resurvey Notes S56°W 44.50' Steel post
Set New Wood Post S55°E 69.42' Fence post
Sugar 10" S08°W 51 links
Elm 14" N60°E 34 links

08-04-89 - James H. Granger
Found Bolt
N75°W 64.24' Conc. R.O.W. Marker
N85°E 56.90' Power pole

B. Description of corner evidence found and/or method applied in restoring or reestablishing corner:

Bolt in Monument Box
S52°W 44.90' Sign post (East post)
N69°W 64.50' R.O.W. Marker
S88°W 56.85' Power pole
S60°E 69.25' Fence post


Replaced Bolt with Cheboygan County Remonumentation Monument in Monument Box.

C. Description of monument for corner and accessories established to perpetuate locating the position of the corner:

Cheboygan County Remonumentation Monument
S52°W 44.90' Sign post (East post)
N69°W 64.50' R.O.W. Marker
S88°W 56.85' Power pole
S60°E 69.25' Fence post

LIBER **010** PAGE **81**

Morris A. ...

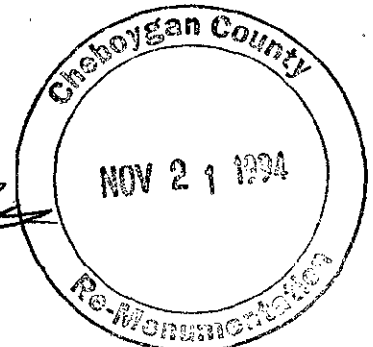

igned by Ronald R. Bischer Date Oct. 25, 1994

urveyor's Michigan License No. 22428