

SURVEY & REMONUMENTATION

CHEBOYGAN COUNTY REMONUMENTATION CORNER

MAY 03 1995

LAND CORNER RECORDATION CERTIFICATE

Filing Requirement of Act 74, Mich. P.A. 1970

RECEIVED
FOR RECORD

94 NOV 22 AM 10:38

COMMISSION

Joanna Spray
CLERK/REGISTER
CHEBOYGAN COUNTY, MICHIGAN

For corners in

CHEBOYGAN
(County)

Located In:

Corner Code #

- | | | | |
|---------------------------------------|--------------------------|------------|--|
| 1. Public Land Survey | T <u>37N</u> R <u>1W</u> | <u>C-7</u> | |
| | T _____ R _____ | | |
| | T _____ R _____ | | |
| | T _____ R _____ | | |
| 2. Property Controlling
in Section | S _____ T _____ R _____ | | |
| | S _____ T _____ R _____ | | |
| 3. Miscellaneous
Property in Sec. | S _____ T _____ R _____ | | |
| | S _____ T _____ R _____ | | |

Register of Deeds Stamp & File Number

4. Lot No. _____, Recorded Plat _____
5. Private Claims _____

	A	B	C	D	E	F	G	H	I	J	K	L	M
2	6		5		4		3		2				
3													
4	7		8		9		10		11		12		
5													
6	18		17		16		15		14		13		
7													
8	19		20		21		22		23		24		
9													
10	30		29		28		27		26		25		
11													
12	31		32		33		34		35		36		
13													

I, Ronald Bischer, in a field survey on July 8, 1994, do hereby certify that under requirements of P.A. 74, Michigan P.A. of 1970, the corner points mentioned in lines 1 and 2 above were in conformance with regulations and rules therefore as required in the current manual of survey instructions of the United States Department of the Interior, Bureau of Land Management or by a decree of a Court of Law and/or that the corner points mentioned in lines 3, 4 and 5 above were in conformance with the rules of the Michigan Board of Land Surveyors or by a Decree of a Court of Law; established, re-established, monumented, re-monumented, recovered, found as expressed below:

NOTE: Not more than 4 corners, all in the same town and range, may be recorded on this certificate.

A. Description of original monument and accessories and/or subsequent restoration:


- | | |
|-----------------------------|------------------------------|
| May 1856 GLO Resurvey Notes | Found 5/8" Rod |
| Set Wood Post | S72°30'W 42.55' Power pole |
| Beech 7" S40°E 7 links | S72°E 78.40' 16" Maple |
| Hemlock 12" N08°E 19 links | N69°E 45.22' Fence corner |
| 03-01-61 - Dean DeLaMater | 09-09-87 - James H. Granger |
| Found Axel shaft | 5/8" Rod |
| N25°W 33.30' Tele pole | N68°E 52.14' 10" Apple |
| S57°W 32.48' Tele pole | S65°E 78.20' 20" Maple |
| N74°E 68.05' Tele pole | S80°W 42.12' Power pole |
| 02-01-68 - Orlando Doyle | N28°W 59.39' 12" Scotch pine |

- March 1965 - Kenneth R. Larsen
Axle shaft
N38°E 83.60' SW Cor. chimney
S68°E 78.30' 20" Maple
S72°W 42.90' Power pole
06-01-88 - James H. Granger
5/8" Rod
witnesses same as 09-09-87
(Granger)

B. Description of corner evidence found and/or method applied in restoring or reestablishing corner:

- 5/8" Rod
N63°E 52.14' 12" Apple tree
S68°E 78.20' 22" Maple
S70°W 42.12' Power pole

Replaced 5/8" Rod with Cheboygan County Remonumentation Monument.

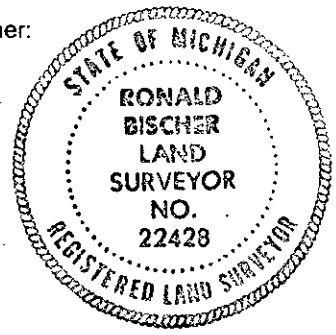


C. Description of monument for corner and accessories established to perpetuate locating the position of the corner:

- Cheboygan County Remonumentation Monument
N63°E 52.14' 12" Apple tree
S68°E 78.20' 22" Maple
S70°W 42.12' Power pole
N31°W 65.95' Lamp post

LIBER **010** PAGE **82**

Maurice O. Rose

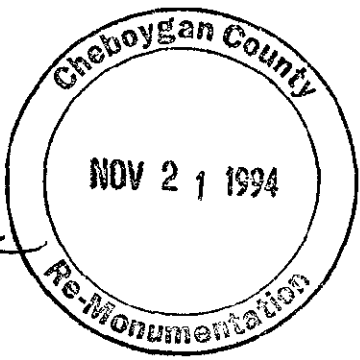

Signed by Ronald R. Bischer Date Oct 25, 1994

Surveyor's Michigan License No. 22428