

SURVEY & REMONUMENTATION

CHEBOYGAN COUNTY REMONUMENTATION CORNER

MAY 03 1995 **LAND CORNER RECORDATION CERTIFICATE**

Filing Requirement of Act 74, Mich. P.A. 1970

COMMISSION

RECEIVED FOR RECORD
94 NOV 22 AM 10:39
James Spang
CLERK/REGISTER
CHEBOYGAN COUNTY, MICHIGAN

For corners in

CHEBOYGAN
(County)

Located In:

Corner Code #/

- | | | |
|------------------------------------|--------------------------|------------|
| 1. Public Land Survey | T <u>37N</u> R <u>1W</u> | <u>C-8</u> |
| | T _____ R _____ | _____ |
| | T _____ R _____ | _____ |
| | T _____ R _____ | _____ |
| 2. Property Controlling in Section | S _____ T _____ R _____ | _____ |
| | S _____ T _____ R _____ | _____ |
| 3. Miscellaneous Property in Sec. | S _____ T _____ R _____ | _____ |
| | S _____ T _____ R _____ | _____ |

Register of Deeds Stamp & File Number

4. Lot No. _____, Recorded Plat _____
5. Private Claims _____


	A	B	C	D	E	F	G	H	I	J	K	L	M
2	6		5		4		3		2		1		
3													
4	7		8		9		10		11		12		
5													
6	18		17		16		15		14		13		
7													
8	19		20		21		22		23		24		
9													
10	30		29		28		27		26		25		
11													
12	31		32		33		34		35		36		
13													

I, Ronald Bischer, in a field survey on July 8, 19 94, do hereby certify that under requirements of P.A. 74, Michigan P.A. of 1970, the corner points mentioned in lines 1 and 2 above were in conformance with regulations and rules therefore as required in the current manual of survey instructions of the United States Department of the Interior, Bureau of Land Management or by a decree of a Court of Law and/or that the corner points mentioned in lines 3, 4 and 5 above were in conformance with the rules of the Michigan Board of Land Surveyors or by a Decree of a Court of Law; established, re-established, monumented, re-monumented, recovered, found as expressed below:

NOTE: Not more than 4 corners, all in the same town and range, may be recorded on this certificate.

A. Description of original monument and accessories and/or subsequent restoration:

- | | |
|-----------------------------|-------------------------------------|
| May 1856 GLO Resurvey Notes | N86°E 28.04' 6" Locust |
| Set Wood Post | S45°E 39.70' 10" Basswood |
| Black Ash 9" N11°E 19 links | 09-01-88 - James H. Granger |
| Cedar 11" S10°W 19 links | 3/4" Rod witnesses same as 08-08-88 |
| 08-08-88 - James H. Granger | 08-24-89 - James H. Granger |
| Found 3/4" Rod | 3/4" Rod witnesses same as 08-08-88 |
| S83°W 39.43' Power pole | |
| N32°W 50.90' 4" Apple tree | |

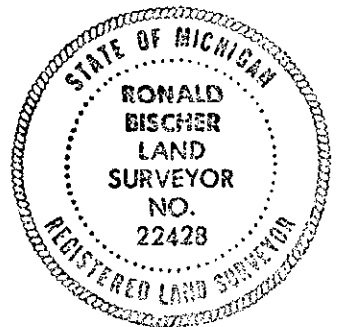

B. Description of corner evidence found and/or method applied in restoring or reestablishing corner:

- 3/4" Rod
S77°W 39.38' Telephone pole
N39°W 50.85' 4" Apple tree
S47°E 39.67' 12" Ash
N87°E 28.03' 7" Elm
- Replaced 3/4" Rod with Cheboygan County Remonumentation Monument.

C. Description of monument for corner and accessories established to perpetuate locating the position of the corner:

- Cheboygan County Remonumentation Monument
S77°W 39.38' Telephone pole
N39°W 50.85' 4" Apple tree
S47°E 39.67' 12" Ash
N87°E 28.03' 7" Elm

LIBER 010 PAGE 83

Marvin O. Pegg



Signed by Ronald R. Bischer Date Oct 25, 1994

Surveyor's Michigan License No. 22428