

SURVEY & REMONUMENTATION

MAY 03 1995

CHEBOYGAN COUNTY REMONUMENTATION CORNER

COMMISSION

LAND CORNER RECORDATION CERTIFICATE

Filing Requirement of Act 74, Mich. P.A. 1970

RECEIVED
FOR RECORD

94 NOV 22 AM 10:40

Joanna Spray
CLERK/REGISTER
CHEBOYGAN COUNTY, MICHIGAN

For corners in

CHEBOYGAN
(County)

Located In:

Corner Code #

1. Public Land Survey	T	37N	R	1W	C-9
	T		R		
	T		R		
	T		R		
	T		R		
2. Property Controlling in Section	S		T	R	
	S		T	R	
3. Miscellaneous Property in Sec.	S		T	R	
	S		T	R	

Register of Deeds Stamp & File Number

4. Lot No. _____, Recorded Plat _____
5. Private Claims _____

	A	B	C	D	E	F	G	H	I	J	K	L	M
2	6		5		4		3		2		1		
3													
4	7		8		9		10		11		12		
5													
6	18		17		16		15		14		13		
7													
8	19		20		21		22		23		24		
9													
10	30		29		28		27		26		25		
11													
12	31		32		33		34		35		36		
13													

I, Ronald Bischer, in a field survey on September 16, 19 94, do hereby certify that under requirements of P.A. 74, Michigan P.A. of 1970, the corner points mentioned in lines 1 and 2 above were in conformance with regulations and rules therefore as required in the current manual of survey instructions of the United States Department of the Interior, Bureau of Land Management or by a decree of a Court of Law and/or that the corner points mentioned in lines 3, 4 and 5 above were in conformance with the rules of the Michigan Board of Land Surveyors or by a Decree of a Court of Law; established, re-established, monumented, re-monumented, recovered, found as expressed below:

NOTE: Not more than 4 corners, all in the same town and range, may be recorded on this certificate.

A. Description of original monument and accessories and/or subsequent restoration:

May 1856 GLO Resurvey Notes	N80°E 47.55' Stop sign
Set Wood Post	
Cedar 10" N11°W 76 links	10-11-91 - James H. Granger
Cedar 6" S30°E 25 links	½" Rod - witnesses same as
	09-28-89 (Granger)
09-28-89 - James H. Granger	
Found ½" Rod	
S38°W 45.50' Power pole	
S75°W 76.60' 30" Pine	
N45°W 46.91' Power pole	

B. Description of corner evidence found and/or method applied in restoring or reestablishing corner:

½" Rod
S72°W 76.60' 30" Black Spruce
N51°W 46.90' Power pole
N74°E 47.58' Stop sign


Replaced ½" Rod with Cheboygan County Remonumentation Monument.

C. Description of monument for corner and accessories established to perpetuate locating the position of the corner:

Cheboygan County Remonumentation Monument
S72°W 76.60' 30" Spruce
N51°W 46.90' Power pole
N74°E 47.58' Stop sign
S69°E 89.85' 6" Spruce

LIBER **010** PAGE **84**

Martin A. Ross

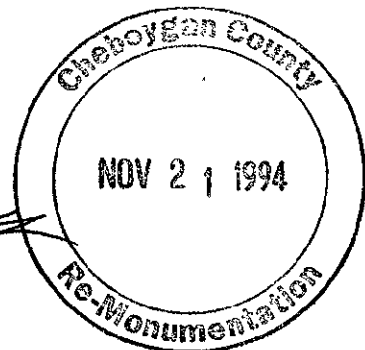

Signed by Ronald R. Bischer

Date Oct 25, 1994

Surveyor's Michigan License No. 22428