

SURVEY & REMONUMENTATION

MAY 03 1995

CHEBOYGAN COUNTY REMONUMENTATION CORNER

RECEIVED
FOR RECORD

LAND CORNER RECORDATION CERTIFICATE COMMISSION Filing Requirement of Act 74, Mich. P.A. 1970

94 NOV 22 AM 10:41

For corners in

CHEBOYGAN
(County)

Located In:

Corner Code #

1. Public Land Survey	T	<u>37N</u>	R	<u>1W</u>	<u>C-10</u>
	T		R		
	T		R		
	T		R		
2. Property Controlling in Section	S		T	R	
	S		T	R	
3. Miscellaneous Property in Sec.	S		T	R	
	S		T	R	

James Spray
CLERK/REGISTER
CHEBOYGAN COUNTY, MICHIGAN

Register of Deeds Stamp & File Number

4. Lot No. _____, Recorded Plat _____
5. Private Claims _____


	A	B	C	D	E	F	G	H	I	J	K	L	M
2	6	5	4	3	2	1							
3													
4	7	8	9	10	11	12							
5													
6	18	17	16	15	14	13							
7													
8	19	20	21	22	23	24							
9													
10	30	29	28	27	26	25							
11													
12	31	32	33	34	35	36							
13													

I, Ronald Bischer, in a field survey on September 15, 19 94, do hereby certify that under requirements of P.A. 74, Michigan P.A. of 1970, the corner points mentioned in lines 1 and 2 above were in conformance with regulations and rules therefore as required in the current manual of survey instructions of the United States Department of the Interior, Bureau of Land Management or by a decree of a Court of Law and/or that the corner points mentioned in lines 3, 4 and 5 above were in conformance with the rules of the Michigan Board of Land Surveyors or by a Decree of a Court of Law; established, re-established, monumented, re-monumented, recovered, found as expressed below:

NOTE: Not more than 4 corners, all in the same town and range, may be recorded on this certificate.

A. Description of original monument and accessories and/or subsequent restoration:

May 1856 GLO Resurvey Notes	S63°E 30.70'	Power pole
Set Wood Post		
Cedar 10" N11°W 37 links (dead)	05-24-93 - Norman J. Quaine	
no green trees available - burnt area	Found ½" Pipe	
09-01-88 - James H. Granger	N75°W 36.11'	10" R. Maple
Found ½" Pipe	S54°W 46.08'	4" W. Birch
N75°W 36.11' 10" R. Maple	S40°E 23.00'	6" Willow
S54°W 46.08' 4" W. Birch	S63°E 30.75'	Power pole
S40°E 23.00' 6" Willow		

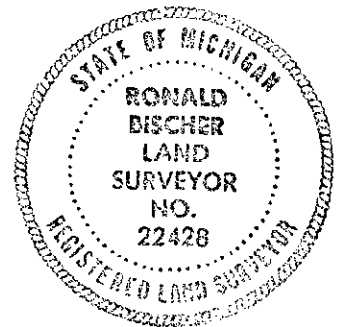

B. Description of corner evidence found and/or method applied in restoring or reestablishing corner:

½" Pipe
 S43°E 23.00' 8" Willow
 S68°E 30.70' Power pole
 N85°W 36.11' 12" Red Maple
 S51°W 46.08' 5" White Birch


Replaced ½" Pipe with Cheboygan County Remonumentation Monument.

C. Description of monument for corner and accessories established to perpetuate locating the position of the corner:

Cheboygan County Remonumentation Monument
 S43°E 23.00' 8" Willow
 S68°E 30.70' Power pole
 N85°W 36.11' 12" Red Maple
 S51°W 46.08' 5" White Birch

LIBER **010** PAGE **85**

Martin O'Rad

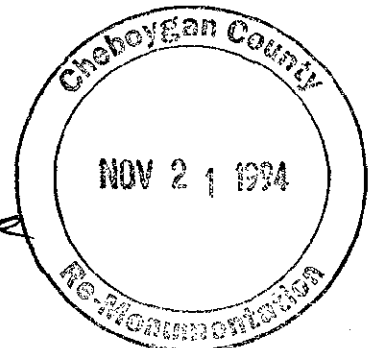

igned by Ronald R. Bischer Date Oct. 25, 1994

urveyor's Michigan License No. 22428