

SURVEY &

CHEBOYAGN COUNTY REMONUMENTATION
LAND CORNER RECORDATION CERTIFICATE

Filing Requirement of Act 74, Mich. P.A. 1970

For corners in

Cheboygan
(County)

JAN 23 1996

Located In:

Corner Code =#

COMMISSION

- | | | | | | |
|------------------------------------|---|-----|---|----|------|
| 1. Public Land Survey | T | 37N | R | 1W | D-11 |
| | T | | R | | |
| | T | | R | | |
| | T | | R | | |
| 2. Property Controlling in Section | S | | T | R | |
| | S | | T | R | |
| 3. Miscellaneous Property in Sec. | S | | T | R | |
| | S | | T | R | |
4. Lot No. _____, Recorded Plat _____
5. Private Claims _____

RECEIVED FOR RECORD

95 DEC 11 PM 4:56

James H. Granger
CLERK/REGISTER
CHEBOYAGN COUNTY, MICHIGAN

Register of Deeds Stamp & File Number

I, James H. Granger, in a field survey on August 4, 19 95, do hereby certify that under requirements of P.A. 74, Michigan P.A. of 1970, the corner points mentioned in lines 1 and 2 above were in conformance with regulations and rules therefore as required in the current manual of survey instructions of the United States Department of the Interior, Bureau of Land Management or by a decree of a Court of Law and/or that the corner points mentioned in lines 3, 4 and 5 above were in conformance with the rules of the Michigan Board of Land Surveyors or by a Decree of a Court of Law; established, re-established, monumented, re-monumented, recovered, found as expressed below:

NOTE: Not more than 4 corners, all in the same town and range, may be recorded on this certificate.

	A	B	C	D	E	F	G	H	I	J	K	L	M
2	6	5	4	3	2								
3													
4	7	8	9	10	11	12							
5													
6	18	17	16	15	14	13							
7													
8	19	20	21	22	23	24							
9													
10	30	29	28	27	26	25							
11													
12	31	32	33	34	35	36							
13													

A. Description of original monument and accessories and/or subsequent restoration:

1840 Original Survey Set wood post, 24" Hemlock N70°E 20 lks, 12" G. Birch S62°W 6 lks
John Mullett


- | | |
|---------------------------------------|---------------------------------------|
| 1951 LCRC Orlando Doyle #7319 pipe | 1983 Survey Orlando Doyle # 7319 |
| 1956 Survey Orlando Doyle # 7319 pipe | 1995 Remonumentation James H. Granger |
| 1956 Subdivision Orlando Doyle #7319 | #16041 |
| 1959 Road Survey Orlando Doyle #7319 | |
| 1959 Survey Orlando Doyle # 7319 | |
| 1967 Survey Orlando Doyle # 7319 | |

B. Description of corner evidence found and/or method applied in restoring or reestablishing corner:

Found concrete monument. Placed remonumentation cap on concrete monument in monument box.

LIBER 010 PAGE 133


James H. Granger

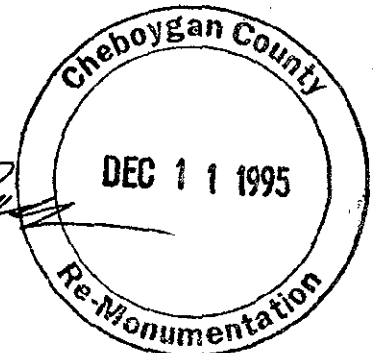

C. Description of monument for corner and accessories established to perpetuate locating the position of the corner:

remonumentation cap on concrete monument in monument box.

- | | | |
|------------|--------------|-----------------|
| 18" Spruce | N16°E 33.79' | Fd tag |
| 16" Cedar | N37°W 41.81 | Fd tag |
| 18" Poplar | S52°E 39.23 | Set nail w/ tag |
| 6" Birch | S45°W 21.66 | Set nail w/ tag |

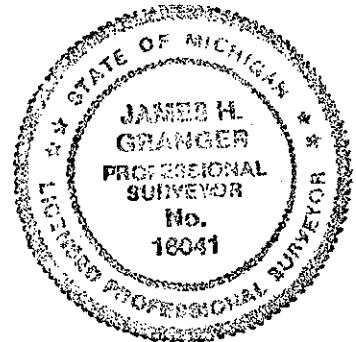

Signed by James H. Granger

Date 10/23/95

Surveyor's Michigan License No. 16041