

**SURVEY & MONUMENTATION**

**CHEBOYGAN COUNTY REMONUMENTATION LAND CORNER RECORDATION CERTIFICATE**

**JAN 23 1996 Filing Requirement of Act 74, Mich. P.A. 1970**

RECEIVED FOR RECORD

95 DEC 11 PM 4:53

*James H. Granger*  
CLERK/REGISTER  
CHEBOYGAN COUNTY, MICHIGAN

For corners in  
Cheboygan  
(County)

COMMISSION

Corner Code =#

1. Public Land Survey	T	<u>37N</u>	R	<u>1W</u>	<u>E-11</u>	
	T	_____	R	_____	_____	
	T	_____	R	_____	_____	
	T	_____	R	_____	_____	
2. Property Controlling in Section	S	_____	T	_____	R	_____
	S	_____	T	_____	R	_____
3. Miscellaneous Property in Sec.	S	_____	T	_____	R	_____
	S	_____	T	_____	R	_____

Register of Deeds Stamp & File Number

4. Lot No. \_\_\_\_\_, Recorded Plat \_\_\_\_\_  
5. Private Claims \_\_\_\_\_

	A	B	C	D	E	F	G	H	I	J	K	L	M
2	6		5		4		3		2		1		
3													
4	7		8		9		10		11		12		
5													
6	18		17		16		15		14		13		
7													
8	19		20		21		22		23		24		
9													
10	30		29		28		27		26		25		
11													
12	31		32		33		34		35		36		
13													

I, James H. Granger, in a field survey on August 4, 1995, do hereby certify that under requirements of P.A. 74, Michigan P.A. of 1970, the corner points mentioned in lines 1 and 2 above were in conformance with regulations and rules therefore as required in the current manual of survey instructions of the United States Department of the Interior, Bureau of Land Management or by a decree of a Court of Law and/or that the corner points mentioned in lines 3, 4 and 5 above were in conformance with the rules of the Michigan Board of Land Surveyors or by a Decree of a Court of Law; established, re-established, monumented, re-monumented, recovered, found as expressed below:

NOTE: Not more than 4 corners, all in the same town and range, may be recorded on this certificate.

A. Description of original monument and accessories and/or subsequent restoration:

1840 Original Survey Set wood post 24" Hemlock N45°E 61ks, 16" Sugar SW 211ks  
John Mullett


1971 Subdivision Kenneth Larson # 10695 conc. mon.  
1974 LCRC Orlando Doyle #7319 3/4" rod

B. Description of corner evidence found and/or method applied in restoring or reestablishing corner:

Found 3/4" rod in monument box. Replaced with 5/8" rebar and remonumentation cap.

LIBER 010 PAGE 132


*Monument Rest*

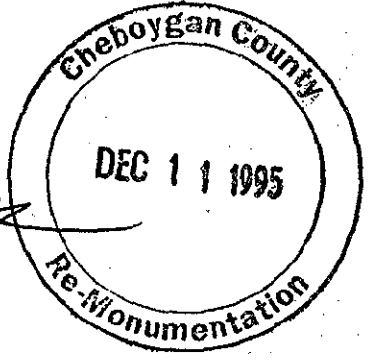

Description of monument for corner and accessories established to perpetuate locating the position of the corner:

5/8" rebar and remonumentation cap. in monument box.

PP	S42°W	35.92	Set nail w/ tag
PP	N33°W	58.47	Fd MDSH tag
PP	N52°E	54.02	Fd MDSH tag
PP	S17°E	119.81	Fd nail w/washer

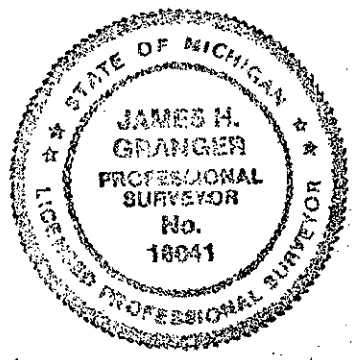

Surveyed by James H. Granger  
Surveyor's Michigan License No. 16041

Date 10/23/95