

SURVEY & MONUMENTATION

CHEBOYGAN COUNTY REMONUMENTATION LAND CORNER RECORDATION CERTIFICATE

JAN 23 1996

Filing Requirement of Act 74, Mich. P.A. 1970

For corners in

Cheboygan (County)

COMMISSION Located In:

Corner Code #

1. Public Land Survey	T	37N	R	1W	E-12
	T		R		
	T		R		
	T		R		
2. Property Controlling in Section	S		T	R	
	S		T	R	
3. Miscellaneous Property in Sec.	S		T	R	
	S		T	R	

RECEIVED FOR RECORD
95 DEC 11 PH 4:51
Joanna Spray
CLERK/REGISTER
CHEBOYGAN COUNTY, MICHIGAN

Register of Deeds Stamp & File Number

4. Lot No. _____, Recorded Plat _____
5. Private Claims _____

A	B	C	D	E	F	G	H	I	J	K	L	M
2	6	5	4	3	2	1						
3												
4	7	8	9	10	11	12						
5												
6	18	17	16	15	14	13						
7												
8	19	20	21	22	23	24						
9												
10	30	29	28	27	26	25						
11												
12	31	32	33	34	35	36						
13												

I, James H. Granger, in a field survey on August 4, 19 95, do hereby certify that under requirements of P.A. 74, Michigan P.A. of 1970, the corner points mentioned in lines 1 and 2 above were in conformance with regulations and rules therefore as required in the current manual of survey instructions of the United States Department of the Interior, Bureau of Land Management or by a decree of a Court of Law and/or that the corner points mentioned in lines 3, 4 and 5 above were in conformance with the rules of the Michigan Board of Land Surveyors or by a Decree of a Court of Law; established, re-established, monumented, re-monumented, recovered, found as expressed below:

NOTE: Not more than 4 corners, all in the same town and range, may be recorded on this certificate.

A. Description of original monument and accessories and/or subsequent restoration:


1840 Original Survey Set wood post 10" Birch S25°W 21ks 9" Birch N7°E 131ks
John Mullett
1963 Survey Orlando Doyle # 7319
1979 Survey Orlando Doyle # 7319

B. Description of corner evidence found and/or method applied in restoring or reestablishing corner:

Found 1 1/4" pipe in monument box. Replaced with 5/8" rebar and remonumentation cap

LIBER 010 PAGE 131


Maurice P. Ross

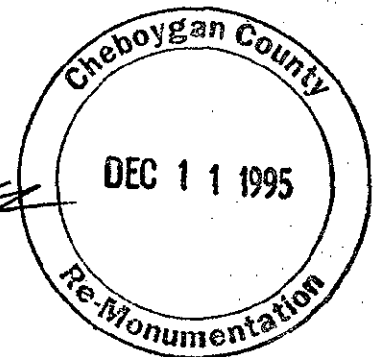

C. Description of monument for corner and accessories established to perpetuate locating the position of the corner:

5/8" rebar and remonumentation cap in monument box.

6" Cedar fence post	N69°59'W	41.42	Set nail w/ tag
3" White Pine	S69°09'W	102.06	Set nail w/ tag
17" Twin Oak	S21°45'E	70.88	Set nail w/ tag
9" Boxelder	N56°16'E	46.70	Set nail w/ tag

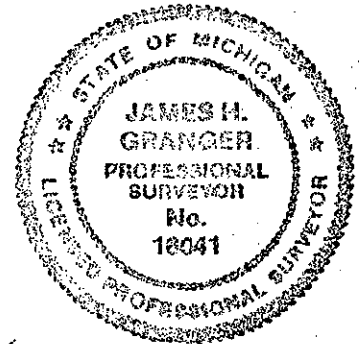

Signed by James H. Granger

Date 10/23/95

Surveyor's Michigan License No. 16041