

MICHIGAN
DEPARTMENT OF CONSERVATION
FORESTRY DIVISION

LAND CORNER RECORD

T. 37 N. R. 1 W.


Cheboygan COUNTY

DESCRIPTION OF CORNER 1/4 corner common to Sections 2 - 11

CORNER MONUMENT Set 1" pipe with 4" brass cap

DATE MONUMENT PLACED AND WITNESSED November 21, 1963

WITNESSES TO CORNER.....

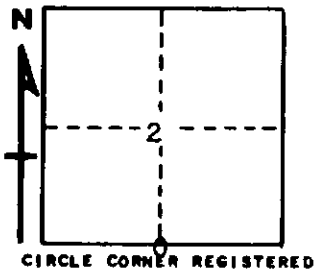

48" W. Pine stp S 55 W 93.7'

24" W. Pine stp N 1 E 74.5'

AND

DESCRIPTION IN DETAIL AS TO HOW CORNER WAS LOCATED AND IDENTIFIED OR RESTORED.

This corner was restored by proportionate measurement, midpoint on line, between section corners. Nothing left for U. S. BTs.

SURVEYOR'S SEAL

SIGNED *Kenneth J. Pettig* DATE December 16, 1963
REGISTERED LAND SURVEYOR
#10,068