

MAR 22 1999

1998

CHEBOYGAN COUNTY REMONUMENTATION
LAND CORNER RECORDATION CERTIFICATE
Filing Requirement of Act 74, Mich. P.A. 1970

SECTION

For corners in
Cheboygan
(County)

Located In:	Corner Code #
T 36N R 3W	B-1
T 37N R 3W	B-13 ✓
T R	
T R	
S T R	
S T R	
S T R	
S T R	

RECEIVED FOR RECORD 1-8-99
at 8:56 O'Clock A.M

James Gray

CLERK/REGISTER
CHEBOYGAN COUNTY, MICHIGAN

Register of Deeds Stamp & File Number

1. Public Land Survey

2. Property Controlling in Section

3. Miscellaneous Property in Sec.

4. Lot No. _____, Recorded Plat _____

5. Private Claims _____

I, Brian K. Fullford, in a field survey on June, 1998 do hereby state that under requirements of P.A. 74, Michigan P.A. of 1970, the corner points mentioned in lines 1 and 2 above were in conformance with regulations and rules therefore as required in the current manual of survey instructions of the United States Department of the Interior, Bureau of Land Management or by a decree of a Court of Law and/or that the corner points mentioned in lines 3, 4 and 5 above were in conformance with the rules of the Michigan Board of Land Surveyors or by a Decree of a Court of Law, established, re-established, monumented, recovered, found as expressed below:

NOTE: Not more than 2 corners, all in the same town and range, may be recorded on this certificate.

NOTE: THIS CORNER IS ALSO DESIGNATED CODE B-13, T37N-R3W.


	A	B	C	D	E	F	G	H	I	J	K	L	M
1		●											
2	6		5		4		3		2		1		
3													
4	7		8		9		10		11		12		
5													
6	18		17		16		15		14		13		
7													
8	19		20		21		22		23		24		
9													
10	30		29		28		27		26		25		
11													
12	31		32		33		34		35		36		
13													

A. Description of original monument and accessories and/or subsequent restoration:

G.L.O.	Sept 1976
1840 John Mullett	Herbert Fluharty #18223
Original Survey	Found pipe
Set 1/4 post	3' S centerline Co. Rd. C-64
15" Hemlock N 52° W 15 lks (9.90')	62' East Trail to South
12" Hemlock N 59° E 31 lks (20.46')	P.P. S 85° W 170.80'
	P.P. N 76° E 164.22'
	12" Maple Cluster S 19° E 77.64'

B. Description of corner evidence found and/or method applied in restoring or reestablishing corner:

Fnd 1 1/4" pipe under Asphalt Rd.
3' South Centerline Co. Rd. C-64
60' East Trail to South
P.P. S 81° W 170.65' w/nail
P.P. N 76° E 165.02' w/nail
12" Maple Cluster S 19° E 77.12'

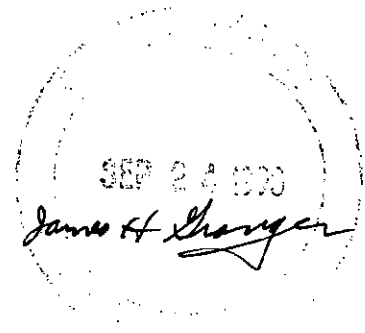

C. Description of monument for corner and accessories established to perpetuate locating the position of the corner:

B-1 Placed 5/8" rebar with remonumentation cap inside pipe in monument box, and position is accepted as a careful and faithful perpetuation of the original corner.

3' South of Centerline Co. Rd. C-64	
60' East Trail to South	
P.Pole S 81° W 170.65'	w/nail
P.Pole N 76° E 165.02'	w/nail
12" Maple Cluster S 19° E 77.12'	Set tag 41099
6" Oak S 01° E 51.17'	Set tag 41099

Signed by *B. K. Fullford*
Surveyor's Michigan License No. 41099

Date 11/23/98

