

SURVEY & REMONUMENTATION

SEP 22 1999

1998

SECTION

**CHEBOYGAN COUNTY REMONUMENTATION
LAND CORNER RECORDATION CERTIFICATE
Filing Requirement of Act 74, Mich. P.A. 1970**

For corners in

Cheboygan

(County)

Located in:

Corner Code #

1. Public Land Survey

T36N R 3W

I-1

T37N R 3W

I-13 ✓

T R

T R

2. Property Controlling in Section

S T R

S T R

3. Miscellaneous Property in Sec.

S T R

S T R

RECEIVED FOR RECORD 1-8-99
at 9:11 O'Clock A M

Joanne Spray

CLERK/REGISTER
CHEBOYGAN COUNTY, MICHIGAN

Register of Deeds Stamp & File Number

4. Lot No. _____, Recorded Plat _____

5. Private Claims _____

I, Brian K. Fullford, in a field survey on June, 1998 do hereby state that under requirements of P.A. 74, Michigan P.A. of 1970, the corner points mentioned in lines 1 and 2 above were in conformance with regulations and rules therefore as required in the current manual of survey instructions of the United States Department of the Interior, Bureau of Land Management or by a decree of a Court of Law and /or that the corner points mentioned in lines 3, 4 and 5 above were in conformance with the rules of the Michigan Board of Land Surveyors or by a Decree of a Court of Law, established, re-established, monumented, recovered, found as expressed below:

NOTE: Not more than 2 corners, all in the same town and range, may be recorded on this certificate.

NOTE: THIS CORNER IS ALSO DESIGNATED AS CODE I-13 IN T37N-R3W.

A	B	C	D	E	F	G	H	I	J	K	L	M
1												
2	6	5	4	3	2	1						
3												
4	7	8	9	10	11	12						
5												
6	18	17	16	15	14	13						
7												
8	19	20	21	22	23	24						
9												
10	30	29	28	27	26	25						
11												
12	31	32	33	34	35	36						
13												

A. Description of original monument and accessories and/or subsequent restoration:


1840 John Mullett
Original Survey
Set Post
16" Hemlock N 60° W 19 lks
14" Hemlock N 62° E 51 lks

1905 David Bowen
County Surveyor
Fnd 6" Round Cedar Post
16" Hemlock stump N 60° W
12.54'
14" Hemlock stump N 62° E
33.66'

1970 Doyle Civil Engineers
#7319
Survey Drawing Only
June 1990 Richard Dunn
#12020
Fnd Iron No wits given

B. Description of corner evidence found and/or method applied in restoring or reestablishing corner:

Fnd 1" pipe
15" Twin Oak South 10.91' w/ old blaze
15" Tw. Oak S 39° W 23.69' w/ old blaze
15" Tw. Oak S 83° W 41.95' w/ old blaze
18" Tw. Oak N 51° W 34.02' w/ old blaze
N 86° W 112' +/- intersection of 2 track to North,
South & West

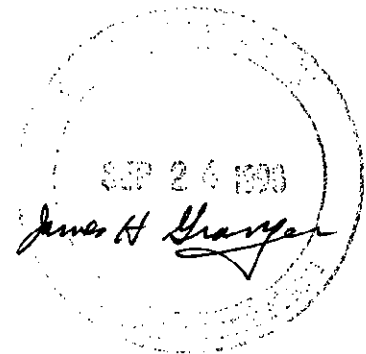

C. Description of monument for corner and accessories established to perpetuate locating the position of the corner:

I-1 Placed 5/8" rebar with remonumentation cap inside pipe, and position is accepted as a careful and faithful perpetuation of the original corner.

15" Twin Oak South 10.91' Set tag 41099
15" Tw. Oak S 39° W 23.69' Set tag 41099
15" Tw. Oak S 83° W 41.95' Set tag 41099
18" Tw. Oak N 51° W 34.02' Set tag 41099
N 86° W 112' +/- intersection of 2 track to North,
South & West



Signed by *B. K. Fullford*
Surveyor's Michigan License No. 41099

Date 11/23/98