

CHEBOYGAN COUNTY REMONUMENTATION CORNER

MAY 05 1997

LAND CORNER RECORDATION CERTIFICATE
Filing Requirement of Act 74, Mich. P.A. 1970

For corners in
CHEBOYGAN

_____	Located In:	Corner Code #
(County)		
1. Public Land Survey	T <u>38N</u> R <u>3W</u>	<u>M-13</u>
	T _____ R _____	<u>M-1</u>
	T <u>37</u> R <u>3W</u>	
	T _____ R _____	
2. Property Controlling in Section	S _____ T _____ R _____	
	S _____ T _____ R _____	
3. Miscellaneous Property in Sec.	S _____ T _____ R _____	
	S _____ T _____ R _____	

RECEIVED
FOR RECORD
96 OCT 30 PM 12:23
Joanne Spray
CLERK/REGISTER
CHEBOYGAN COUNTY, MICHIGAN
Register of Deeds Stamp & File Number

4. Lot No. _____, Recorded Plat _____

5. Private Claims _____

I, JAMES H. GRANGER, in a field survey on SEPTEMBER 24, 1996 do hereby state that under requirements of P.A. 74, Michigan P.A. of 1970, the corner points mentioned in lines 1 and 2 above were in conformance with regulations and rules therefore as required in the current manual of survey instructions of the United States Department of the Interior, Bureau of Land Management or by a decree of a Court of Law and /or that the corner points mentioned in lines 3, 4 and 5 above were in conformance with the rules of the Michigan Board of Land Surveyors or by a Decree of a Court of Law; established, re-established, monumented, recovered, found as expressed below:

NOTE: Not more than 2 corners, all in the same town and range, may be recorded on this certificate.

1	A	B	C	D	E	F	G	H	I	J	K	L	M
2	6	5	4	3	2	1							
3													
4	7	8	9	10	11	12							
5													
6	18	17	16	15	14	13							
7													
8	19	20	21	22	23	24							
9													
10	30	29	28	27	26	25							
11													
12	31	32	33	34	35	36							
13													

A. Description of original monument and accessories and/or subsequent restoration:

1840 Original Survey Set wood post 8" Spruce N55°E 12 lks
John Mullett 8" Spruce S51°W 6 lks


19772 LCRC Set 3/4" pipe
Orlando Doyle # 7319

B. Description of corner evidence found and/or method applied in restoring or reestablishing corner:

Found 3/4" pipe and three Doyle witnesses overgrown.

Mount. Post


LIBER 010 PAGE 180

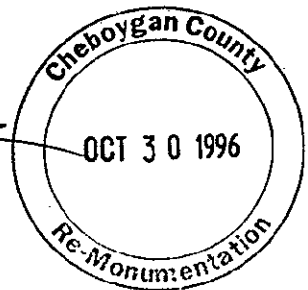

C. Description of monument for corner and accessories established to perpetuate locating the position also corners A-13, T38N, R2W A-1, T37N, R2W M-1 T37N, R3W

Set 5/8" x 30" rebar with Remonumentation Cap

8" Tamarack	N23°W	7.41'	Set nail w/tag
8" Tamarack	N43°E	10.56'	Set nail w/tag
6" Tamarack	S76°E	5.08'	Set nail w/tag
8" Tamarack	S39°W	5.82'	Set nail w/tag

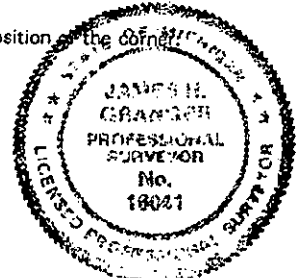

Signed by *James H. Granger*
Surveyor's Michigan License No. 16041

Date 10-10-96