

SURVEY & REMONUMENTATION
CHEBOYGAN COUNTY REMONUMENTATION CORNER

MAY 05 1997

LAND CORNER RECORDATION CERTIFICATE
Filing Requirement of Act 74, Mich. P.A. 1970

corners in **CHEBOYGAN** **COMMISSION**
 Located In: _____ Corner Code # _____
 (County)

Public Land Survey T 37N R 3W _____ M-4
 T _____ R _____
 T _____ R _____
 T _____ R _____

Property Controlling S _____ T _____ R _____
 in Section S _____ T _____ R _____
 Miscellaneous S _____ T _____ R _____
 Property in Sec. S _____ T _____ R _____

RECEIVED
 FOR RECORD
 96 OCT 30 PM 12:27
James H. Granger
 CLERK/REGISTER
 CHEBOYGAN COUNTY, MICHIGAN
 Register of Deeds Stamp & File Number

Lot No. _____, Recorded Plat _____
 Private Claims _____

JAMES H. GRANGER, in a field survey on SEPTEMBER 24, 1996
 hereby state that under requirements of P.A. 74, Michigan P.A. of 1970, the corner points
 mentioned in lines 1 and 2 above were in conformance with regulations and rules therefore as
 required in the current manual of survey instructions of the United States Department of the Interior,
 Bureau of Land Management or by a decree of a Court of Law and for that the corner points
 mentioned in lines 3, 4 and 5 above were in conformance with the rules of the Michigan Board of
 Surveyors or by a Decree of a Court of Law; established, re-established, monumented,
 verified, found as expressed below:

	A	B	C	D	E	F	G	H	I	J	K	L	M
1													
2		6		5		4		3		2		1	
3													
4		7		8		9		10		11		12	
5													
6		16		17		16		15		14		13	
7													
8		19		20		21		22		23		24	
9													
10		30		29		28		27		26		25	
11													
12		31		32		33		34		35		36	
13													


Note: Not more than 2 corners, all in the same town and range, may be recorded on this certificate.

Description of original monument and accessories and/or subsequent restoration:

- 1840 Original Survey John Mullett Set wood post 10" Tamarack S70°W 4 lks
 10" Cedar N33°E 5 lks
- 1994 LCRC Norman Quaine #33984 1" pipe

Description of corner evidence found and/or method applied in restoring or reestablishing corner:
 Found 1" pipe and three witnesses.


Marvin A. [Signature]

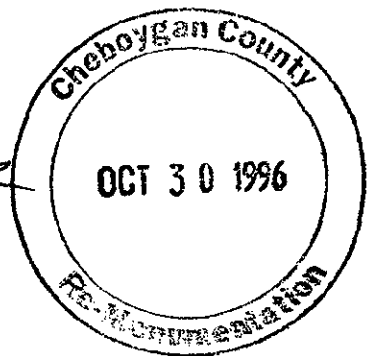

LIBER **010** PAGE **183**

Description of monument for corner and accessories established to perpetuate locating the position of the corner:
also corner A-5, T37N, R2W

- Set 5/8" x 30" rebar with Remonumentation Cap
- Pipe
- Cedar S05°E 8.50' Fd tag
- Cedar N49°W 12.26' Fd tag
- Cedar N19°E 8.48' Fd tag
- Cedar S68°W 10.46' Set nail w/tag

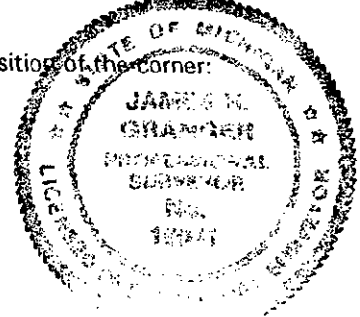

by James H. Granger Date 10-10-96
 Surveyor's Michigan License No. 16041