SURVEY & REMONUMENTATION

NOV 1 5 1999

CHEBOYGAN COUNTY REMONUMENTATION CORNER

LAND CORNER RECORDATION CERTIFICATE

Filing Requirement of Act 74, Mich. P.A. 1970

RECEIVED FOR RECORD
99 OCT 14 PM 12: 28

Dep. #2 pm

Vicky Szczepanski
CLERK/REGISTER
CHEBOYGAN COUNTY MICHIGAN

Re-recorded to correct previous recording in Liber 10 pg. 183.

Register of Deeds Stamp & File Number

For corners in SECTION

CHEBOYGAN (County) Located in: Corner Code #

1. Public Land Survey		T 37N	R 3W	M-4
		T___	R___	
		T___	R___	
		T___	R___	
2. Property Controlling	S___	T___	R___	
in Section	S___	T___	R___	
3. Miscellaneous	S___	T___	R___	
Property in Sec.	S___	T___	R___	

4. Lot No. _____, Recorded Plat _____

5. Private Claims _____

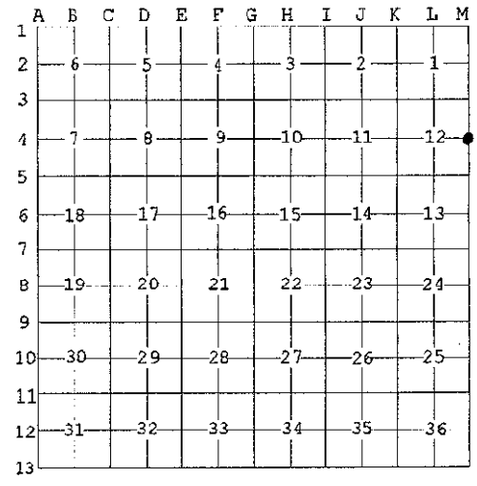

I, JAMES H. GRANGER, in a field survey on SEPTEMBER 24, 19 96 do hereby state that under requirements of P.A. 74, Michigan P.A. of 1970, the corner points mentioned in lines 1 and 2 above were in conformance with regulations and rules therefore as required in the current manual of survey instructions of the United States Department of the Interior, Bureau of Land Management or by a decree of a Court of Law and /or that the corner points mentioned in lines 3, 4 and 5 above were in conformance with the rules of the Michigan Board of Land Surveyors or by a Decree of a Court of Law; established, re-established, monumented, recovered, found as expressed below:

NOTE: Not more than 2 corners, all in the same town and range, may be recorded on this certificate.

A. Description of original monument and accessories and/or subsequent restoration:

1840	Original Survey John Mullett	Set wood post	10" Tamarack	S70°W	4 lks
			10" Cedar	N33°E	5 lks
1994	LCRC Norman Quaine #33984	1" pipe			

Cheboygan County
OCT 3 0 1996
Surveyor Monument

B. Description of corner evidence found and/or method applied in restoring or reestablishing corner:

Found 1" pipe and 3 witnesses.

C. Description of monument for corner and accessories established to perpetuate locating the position of the corner:

Also corner A-4, T37N, R2W

Set 5/8" x 30" rebar with Remonumentation Cap

1" Pipe			
5" Cedar	S05°E	8.50'	Fd tag
8" Cedar	N49°W	12.26'	Fd tag
6" Cedar	N19°E	14.23'	Fd tag
6" Cedar	S68°W	10.46"	Set nail w/tag

STATE OF MICHIGAN
JAMES H. GRANGER
PROFESSIONAL SURVEYOR
No. 16041
LICENSED PROFESSIONAL SURVEYOR

Signed by James H Granger Date April 2, 1999

Surveyor's Michigan License No. 16041

LIBER 011 PAGE 136

FORM APPROVED BY MICHIGAN STATE BOARD OF PROFESSIONAL SURVEYORS, JAN. 28, 1971
REVISED 14,1975
REVISED JAN., 1983
REVISED OCT., 1995