

MAY 05 1997

LAND CORNER RECORDATION CERTIFICATE
Filing Requirement of Act 74, Mich. P.A. 1970

For corners in **CHEBOYGAN**

(County)	Located In:	Corner Code #
1. Public Land Survey	T <u>37N</u> R <u>3W</u>	<u>M-6</u>
	T _____ R _____	_____
	T _____ R _____	_____
	T _____ R _____	_____
2. Property Controlling in Section	S _____ T _____ R _____	_____
	S _____ T _____ R _____	_____
3. Miscellaneous Property in Sec.	S _____ T _____ R _____	_____
	S _____ T _____ R _____	_____

RECEIVED FOR RECORD

96 OCT 30 PM 12: 29

Joanna Sperry
 CLERK/REGISTER
 CHEBOYGAN COUNTY, MICHIGAN

Register of Deeds Stamp & File Number

4. Lot No. _____, Recorded Plat _____

5. Private Claims _____

I, JAMES H. GRANGER, in a field survey on SEPTEMBER 24, 19 96 do hereby state that under requirements of P.A. 74, Michigan P.A. of 1970, the corner points mentioned in lines 1 and 2 above were in conformance with regulations and rules therefore as required in the current manual of survey instructions of the United States Department of the Interior, Bureau of Land Management or by a decree of a Court of Law and for that the corner points mentioned in lines 3, 4 and 5 above were in conformance with the rules of the Michigan Board of Land Surveyors or by a Decree of a Court of Law; established, re-established, monumented, recovered, found as expressed below:

NOTE: Not more than 2 corners, all in the same town and range, may be recorded on this certificate.

	A	B	C	D	E	F	G	H	I	J	K	L	M
1													
2	6		5		4		3		2		1		
3													
4	7		8		9		10		11		12		
5													
6	16		17		16		15		14		13		
7													
8	19		20		21		22		23		24		
9													
10	30		29		28		27		26		25		
11													
12	31		32		33		34		35		36		
13													


A. Description of original monument and accessories and/or subsequent restoration:

- 1840 Original Survey John Mullett Set wood post 12" Beech N82°E 17 lks
8" Beech S30°W 17 lks
- 1980 Survey Orlando Doyle # 7319 1" pipe
- 1984 Survey Orlando Doyle # 7319 1" pipe

B. Description of corner evidence found and/or method applied in restoring or reestablishing corner:

Found 5/8" rod w/ cap # 16051 and two Doyle witnesses. *Maurice A. Rose*


LIBER **010** PAGE **185**

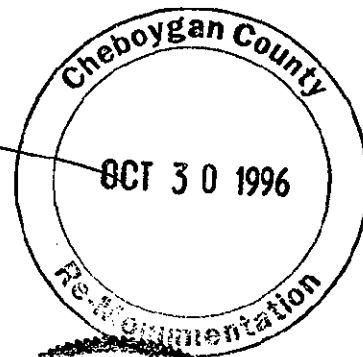

C. Description of monument for corner and accessories established to perpetuate locating the position of the corner **also corner A-6, T37N, R2W**

Used existing 5/8" rebar and palced Remonumentation Cap

5/8" Rod			
12" Apple	N67°E	59.00'	Fd nail & washer
Fence Cor Post	N85°W	32.91'	Fd nail & washer
Fence Post	N32°W	75.52'	Set nail w/tag
PP # 146	S88°E	51.35'	Set nail w/tag

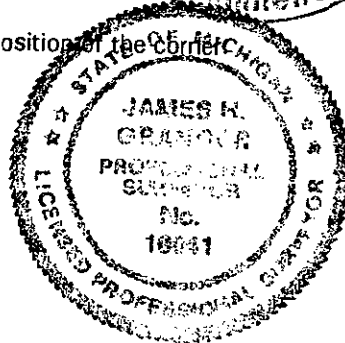

igned by *James H. Granger*
 Surveyor's Michigan License No. 16041

Date 10-10-96