

MAY 05 1997

LAND CORNER RECORDATION CERTIFICATE
Filing Requirement of Act 74, Mich. P.A. 1970

For corners in CHEBOYGAN COMMISSION

(County)	Located In:	Corner Code #
1. Public Land Survey	T <u>37N</u> R <u>3W</u>	<u>M-7</u>
	T _____ R _____	_____
	T _____ R _____	_____
	T _____ R _____	_____
2. Property Controlling in Section	S _____ T _____ R _____	_____
	S _____ T _____ R _____	_____
3. Miscellaneous Property in Sec.	S _____ T _____ R _____	_____
	S _____ T _____ R _____	_____

RECEIVED FOR RECORD
96 OCT 30 PM 12:30
James H. Granger
CLERK/REGISTER
CHEBOYGAN COUNTY, MICHIGAN
Register of Deeds Stamp & File Number

4. Lot No. _____, Recorded Plat _____
5. Private Claims _____

	A	B	C	D	E	F	G	H	I	J	K	L	M
1													
2	6		5		4		3		2		1		
3													
4	7		8		9		10		11		12		
5													
6	18		17		16		15		14		13		
7													
8	19		20		21		22		23		24		
9													
10	30		29		28		27		26		25		
11													
12	31		32		33		34		35		36		
13													

I, JAMES H. GRANGER, in a field survey on SEPTEMBER 24, 1996 do hereby state that under requirements of P.A. 74, Michigan P.A. of 1970, the corner points mentioned in lines 1 and 2 above were in conformance with regulations and rules therefore as required in the current manual of survey instructions of the United States Department of the Interior, Bureau of Land Management or by a decree of a Court of Law and /or that the corner points mentioned in lines 3, 4 and 5 above were in conformance with the rules of the Michigan Board of Land Surveyors or by a Decree of a Court of Law; established, re-established, monumented, recovered, found as expressed below:


NOTE: Not more than 2 corners, all in the same town and range, may be recorded on this certificate.

A. Description of original monument and accessories and/or subsequent restoration:

- 1840 Original Survey John Mullett Set wood post 12" Beech N11°W 27 lks
12" Beech S84°E 17 lks
- 1984 Survey Orlando Doyle # 7319 Found 1 1/4" pipe
- 1988 LCRC James H. Granger # 16041 Found 1 1/4" pipe
- 1994 LCRC Norman Quaine # 33984 Found 1 1/4" pipe

B. Description of corner evidence found and/or method applied in restoring or reestablishing corner:

Found 1 1/4" pipe and four witnesses.

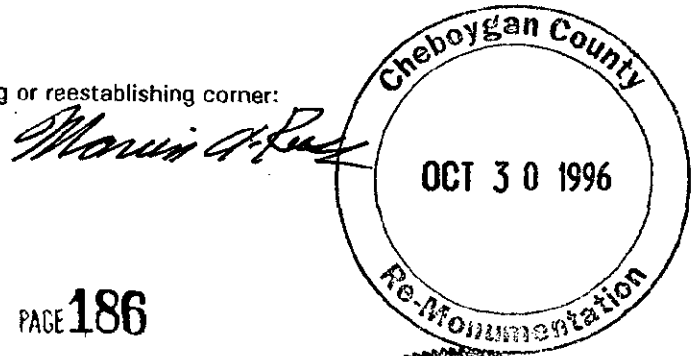


LIBER 010 PAGE 186

Description of monument for corner and accessories established to perpetuate locating the position of the corner: also corner A-7, T37N, R2W

Set 5/8" x 30" rebar inside 1 1/4" pipe with Remonumentation Cap

1 1/4" Pipe			
Power Pole	N48°E	49.31'	Fd tag
Anchor Pole	S25°E	64.00'	Fd tag
Anchor Pole	N46°W	56.08'	Fd tag
Fence Post	S59°W	55.30'	Set nail w/tag

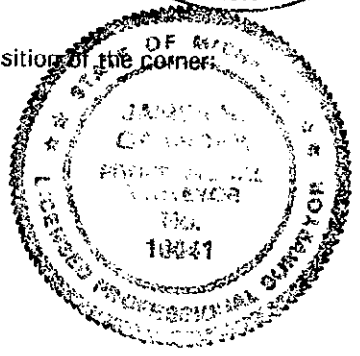

Signed by James H. Granger
Surveyor's Michigan License No. 16041

Date 10-10-96