

SURVEY & REMONUMENTATION

CHEBOYGAN COUNTY REMONUMENTATION CORNER

MAY 05 1997

LAND CORNER RECORDATION CERTIFICATE
Filing Requirement of Act 74, Mich. P.A. 1970

For corners in
CHEBOYGAN
COMMISSION

	Located In:	Corner Code #
(County)		
1. Public Land Survey	T <u>37N</u> R <u>3W</u>	<u>M-8</u>
	T _____ R _____	_____
	T _____ R _____	_____
	T _____ R _____	_____
2. Property Controlling in Section	S _____ T _____ R _____	_____
	S _____ T _____ R _____	_____
3. Miscellaneous Property in Sec.	S _____ T _____ R _____	_____
	S _____ T _____ R _____	_____

RECEIVED FOR RECORD
 96 OCT 30 PM 12:31
James H. Granger
 CLERK/REGISTER
 CHEBOYGAN COUNTY, MICHIGAN
 Register of Deeds Stamp & File Number

4. Lot No. _____, Recorded Plat _____
 5. Private Claims _____

I, JAMES H. GRANGER, in a field survey on SEPTEMBER 24, 19 96 do hereby state that under requirements of P.A. 74, Michigan P.A. of 1970, the corner points mentioned in lines 1 and 2 above were in conformance with regulations and rules therefore as required in the current manual of survey instructions of the United States Department of the Interior, Bureau of Land Management or by a decree of a Court of Law and /or that the corner points mentioned in lines 3, 4 and 5 above were in conformance with the rules of the Michigan Board of Land Surveyors or by a Decree of a Court of Law; established, re-established, monumented, recovered, found as expressed below:

A	B	C	D	E	F	G	H	I	J	K	L	M
1												
2	6	5	4	3	2	1						
3												
4	7	8	9	10	11	12						
5												
6	18	17	16	15	14	13						
7												
8	19	20	21	22	23	24						
9												
10	30	29	28	27	26	25						
11												
12	31	32	33	34	35	36						
13												

NOTE: Not more than 2 corners, all in the same town and range, may be recorded on this certificate.


A. Description of original monument and accessories and/or subsequent restoration:

- 1840 Original Survey John Mullett Set wood post 10" Beech S81°W 16 lks 8" Sugar N71°E 7 lks
- 1994 LCRC Norman Quaine # 33984 Set 1/2" rod w/cap #15410
- 1994 Survey Norman Quaine # 33984 Found 1/2" rod w/cap # 33984

B. Description of corner evidence found and/or method applied in restoring or reestablishing corner:

Found rod w/cap # 15410 and four witnesses.

Marvin A. Ross

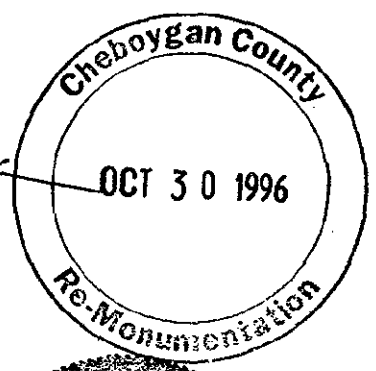


LIBER 010 PAGE 187

C. Description of monument for corner and accessories established to perpetuate locating the position of the corner: also corner A-8, T37N, R2W

Set 5/8" x 30" rebar with Remonumentation Cap

1/2" Rod			
20" Maple	N28°W	52.88'	Fd tag
18" Maple	S53°E	36.13'	Fd tag
Fence Corner	N83°W	41.32'	Fd tag
Power Pole	N80°W	63.05'	Fd tag

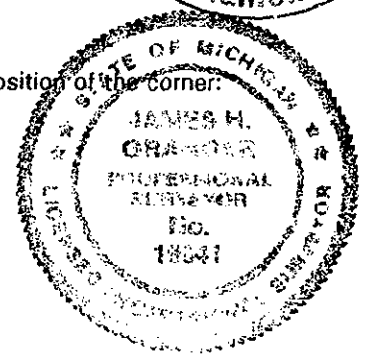

Signed by James H. Granger
 Surveyor's Michigan License No. 16041

Date 10-10-96