

CHEBOYGAN COUNTY REMONUMENTATION CORNER

SURVEY & REMONUMENTATION LAND CORNER RECORDATION CERTIFICATE
 Filing Requirement of Act 74, Mich. P.A. 1970

For corners in CHEBOYGAN MAY 05 1997

COMMISSION (County)

Located In: _____ Corner Code # _____

1. Public Land Survey T 37N R 3W M-10
 T _____ R _____
 T _____ R _____
 T _____ R _____

2. Property Controlling in Section S _____ T _____ R _____
 S _____ T _____ R _____

3. Miscellaneous Property in Sec. S _____ T _____ R _____
 S _____ T _____ R _____

RECEIVED FOR RECORD
 96 OCT 30 PM 12:37
Joseph Spray
 CLERK/REGISTER
 CHEBOYGAN COUNTY, MICHIGAN
 Register of Deeds Stamp & File Number

4. Lot No. _____, Recorded Plat _____

5. Private Claims _____

JAMES H. GRANGER, in a field survey on SEPTEMBER 24, 19 96, do hereby state that under requirements of P.A. 74, Michigan P.A. of 1970, the corner points mentioned in lines 1 and 2 above were in conformance with regulations and rules therefore as required in the current manual of survey instructions of the United States Department of the Interior, Bureau of Land Management or by a decree of a Court of Law and /or that the corner points mentioned in lines 3, 4 and 5 above were in conformance with the rules of the Michigan Board of Land Surveyors or by a Decree of a Court of Law; established, re-established, monumented, re-discovered, found as expressed below:


A	B	C	D	E	F	G	H	I	J	K	L	M
1												
2	6		5		4		3		2		1	
3												
4	7		8		9		10		11		12	
5												
6	18		17		16		15		14		13	
7												
8	19		20		21		22		23		24	
9												
10	30		29		28		27		26		25	
11												
12	31		32		33		34		35		36	
13												

NOTE: Not more than 2 corners, all in the same town and range, may be recorded on this certificate.

- Description of original monument and accessories and/or subsequent restoration:
- 1840 Original Survey John Mullett Set wood post 12" Beech S52°W 8 lks
6" Sugar NO7°E 18 lks
 - 1972 Survey Orlando Doyle # 7319 Found 3/4" iron bar

Description of corner evidence found and/or method applied in restoring or reestablishing corner:
 Found 3/4" rod and two witnesses.


Marvin A. P...

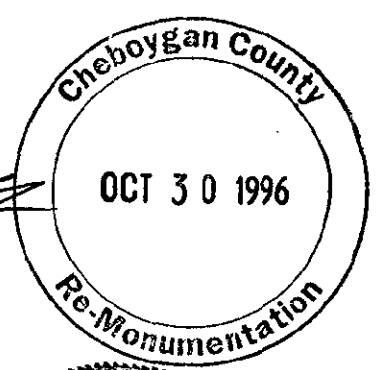

LIBER 010 PAGE 189

Description of monument for corner and accessories established to perpetuate locating the position of the corner:
also corner A-10, T37N, R2W
 Set 5/8" x 30" rebar inside 3/4" pipe with Remonumentation Cap

3/4" Rod			
30" Maple	N19°W	63.69'	Fd nail & washer
24" Maple	S89°W	25.15'	Fd nail & washer
30" Maple	S89°E	34.89'	Set nail w/tag
4" White Pine	S27°W	91.00'	Set nail w/tag

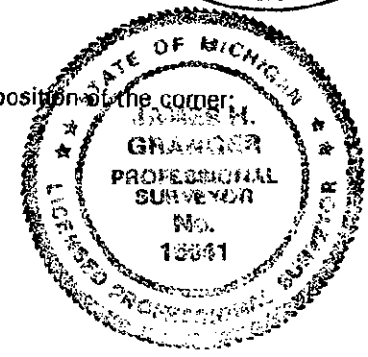

Witnessed by James H. Granger
 Surveyor's Michigan License No. 16041

Date 10-10-96