

CHEBOYGAN COUNTY SURVEY & MONUMENTATION
CHEBOYGAN COUNTY REMONUMENTATION CORNER

LAND CORNER RECORDATION CERTIFICATE

Filing Requirement of Act 74, Mich. P.A. 1970

JAN 23 1996

For corners in

CHEBOYGAN (County) **COMMISSION** located in:

Corner Code #

Munro Township

- | | | |
|------------------------------------|--------------------------|-------------|
| 1. Public Land Survey | T <u>37N</u> R <u>3W</u> | <u>M-12</u> |
| | T _____ R _____ | _____ |
| | T _____ R _____ | _____ |
| | T _____ R _____ | _____ |
| 2. Property Controlling in Section | S _____ T _____ R _____ | _____ |
| | S _____ T _____ R _____ | _____ |
| 3. Miscellaneous Property in Sec. | S _____ T _____ R _____ | _____ |
| | S _____ T _____ R _____ | _____ |

RECEIVED FOR RECORD

95 SEP 18 AM 10:27

James Spray
 CLERK/REGISTER
 CHEBOYGAN COUNTY, MICHIGAN

Register of Deeds Stamp & File Number

4. Lot No. _____, Recorded Plat _____
5. Private Claims _____

I, Ronald Bischer, in a field survey on July 7, 19 95, do hereby certify that under requirements of P.A. 74, Michigan P.A. of 1970, the corner points mentioned in lines 1 and 2 above were in conformance with regulations and rules therefore as required in the current manual of survey instructions of the United States Department of the Interior, Bureau of Land Management or by a decree of a Court of Law and/or that the corner points mentioned in lines 3, 4 and 5 above were in conformance with the rules of the Michigan Board of Land Surveyors or by a Decree of a Court of Law; established, re-established, monumented, re-monumented, recovered, found as expressed below:

NOTE: Not more than 4 corners, all in the same town and range, may be recorded on this certificate.

	A	B	C	D	E	F	G	H	I	J	K	L	M
2	6	5	4	3	2	1							
3													
4	7	8	9	10	11	12							
5													
6	18	17	16	15	14	13							
7													
8	19	20	21	22	23	24							
9													
10	30	29	28	27	26	25							
11													
12	31	32	33	34	35	36							
13													


A. Description of original monument and accessories and/or subsequent restoration:

1840 Original Survey
 John Mullett
 Set wood post
 14" Hemlock S77°W 11 lks
 10" Birch S62°E 16 lks

No record of subsequent restoration.

B. Description of corner evidence found and/or method applied in restoring or reestablishing corner:

Found 1/2" Rod with cap (M. Ross) - replaced with 5/8" Rod and Cheboygan County Remonumentation cap
 Set four witnesses.

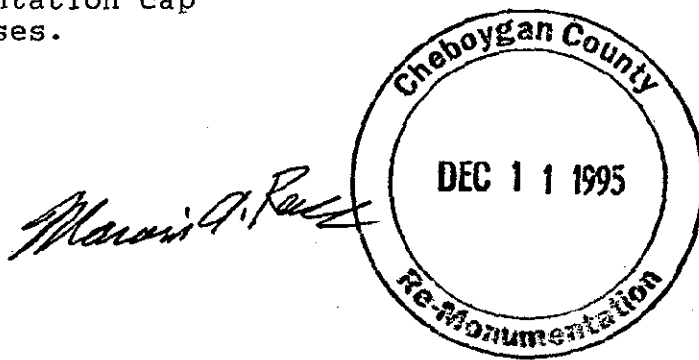

C. Description of monument for corner and accessories established to perpetuate locating the position of the corner:

5/8" Rod with Cheboygan County Remonumentation cap
 N49°E 98.04' 4" Cedar
 N40°W 85.03' 8" Ash
 S54°W 90.90' Power pole
 S47°E 132.45' Power pole

Nails with witness tag #22428 used.

LIBER **010** PAGE **120**

Surveyed by Ronald R. Bischer
 Surveyor's Michigan License No. 22428

Date July 28, 1995