

SURVEY & REMONUMENTATION

NOV 15 1999

CHEBOYGAN COUNTY REMONUMENTATION CORNER

LAND CORNER RECORDATION CERTIFICATE
Filing Requirement of Act 74, Mich. P.A. 1970

RECEIVED FOR RECORD

99 OCT 14 PM 12: 28

Def. #2
pm

For corners in **SECTION**

<u>CHEBOYGAN</u> (County)	Located In:	Corner Code #
1. Public Land Survey	T <u>37NR</u> 3W	<u>M-4</u>
	T <u> </u> R <u> </u>	<u> </u>
	T <u> </u> R <u> </u>	<u> </u>
	T <u> </u> R <u> </u>	<u> </u>
2. Property Controlling in Section	S <u> </u> T <u> </u> R <u> </u>	<u> </u>
	S <u> </u> T <u> </u> R <u> </u>	<u> </u>
3. Miscellaneous Property in Sec.	S <u> </u> T <u> </u> R <u> </u>	<u> </u>
	S <u> </u> T <u> </u> R <u> </u>	<u> </u>

Deily Pyszynski
CLERK/REGISTER
CHEBOYGAN COUNTY MICHIGAN

Re-recorded to correct previous recording in Liber 10 pg. 183.

Register of Deeds Stamp & File Number

4. Lot No. _____, Recorded Plat _____
5. Private Claims _____

1	A	B	C	D	E	F	G	H	I	J	K	L	M
2		6		5		4		3		2		1	
3													
4		7		8		9		10		11		12	
5													
6		18		17		16		15		14		13	
7													
8		19		20		21		22		23		24	
9													
10		30		29		28		27		26		25	
11													
12		31		32		33		34		35		36	
13													

I, JAMES H. GRANGER, in a field survey on SEPTEMBER 24, 19 96 do hereby state that under requirements of P.A. 74, Michigan P.A. of 1970, the corner points mentioned in lines 1 and 2 above were in conformance with regulations and rules therefore as required in the current manual of survey instructions of the United States Department of the Interior, Bureau of Land Management or by a decree of a Court of Law and for that the corner points mentioned in lines 3, 4 and 5 above were in conformance with the rules of the Michigan Board of Land Surveyors or by a Decree of a Court of Law; established, re-established, monumented, recovered, found as expressed below:


NOTE: Not more than 2 corners, all in the same town and range, may be recorded on this certificate.

A. Description of original monument and accessories and/or subsequent restoration:

1840 Original Survey Set wood post 10" Tamarack S70°W 4 lks
John Mullett 10" Cedar N33°E 5 lks

1994 LCRC 1" pipe
Norman Quaine #33984

Marvin C. Ross

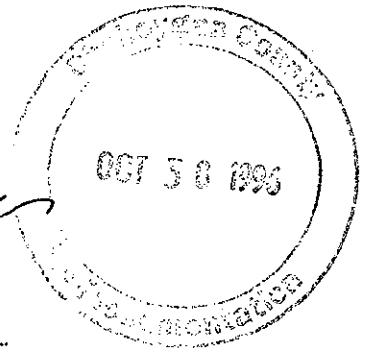

B. Description of corner evidence found and/or method applied in restoring or reestablishing corner:

Found 1" pipe and 3 witnesses.


C. Description of monument for corner and accessories established to perpetuate locating the position of the corner:

Also corner A-4, T37N, R2W

Set 5/8" x 30" rebar with Remonumentation Cap

1" Pipe

5" Cedar	S05°E	8.50'	Fd tag
8" Cedar	N49°W	12.26'	Fd tag
8" Cedar	N19°E	14.23'	Fd tag
6" Cedar	S68°W	10.46"	Set nail w/tag

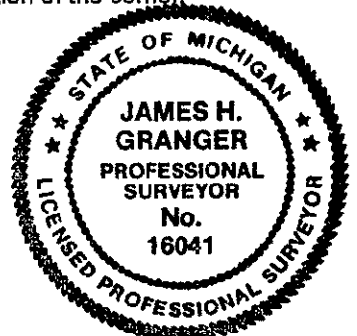

Signed by *James H. Granger*
Surveyor's Michigan License No. 16041

Date April 2, 1999