MAY 2 5 1997

COMMISSION

CHEBOYGAN COUNTY REMONUMENTATION CORNER

LAND CORNER RECORDATION CERTIFICATE
Filing Requirement of Act 74, Mich. P.A. 1970

For corners in CHEBOYGAN (County)

		Located In:	Corner Code #
1. Public Land Survey		T 38N R 3W	M-13
		T___ R___	
		T 37 R 2W	A-1
		T___ R___	
2. Property Controlling	S___	T___ R___	
in Section	S___	T___ R___	
3. Miscellaneous	S___	T___ R___	
Property in Sec.	S___	T___ R___	

RECEIVED FOR RECORD
96 OCT 30 PM 12: 23
Joanne Spray
CLERK/REGISTER
CHEBOYGAN COUNTY, MICHIGAN
Register of Deeds Stamp & File Number

4. Lot No. _____ , Recorded Plat _____

5. Private Claims _____

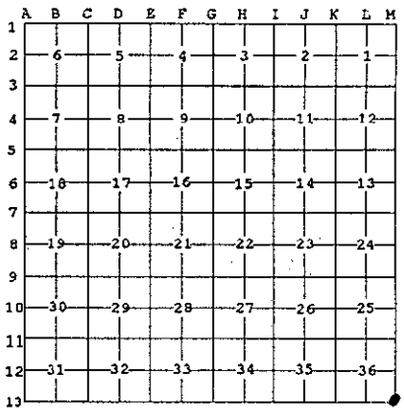

I, JAMES H. GRANGER, in a field survey on SEPTEMBER 24, 19 96 do hereby state that under requirements of P.A. 74, Michigan P.A. of 1970, the corner points mentioned in lines 1 and 2 above were in conformance with regulations and rules therefore as required in the current manual of survey instructions of the United States Department of the Interior, Bureau of Land Management or by a decree of a Court of Law and /or that the corner points mentioned in lines 3, 4 and 5 above were in conformance with the rules of the Michigan Board of Land Surveyors or by a Decree of a Court of Law; established, re-established, monumented, recovered, found as expressed below:

NOTE: Not more than 2 corners, all in the same town and range, may be recorded on this certificate.

A. Description of original monument and accessories and/or subsequent restoration:

1840 Original Survey John Mullett	Set wood post	8" Spruce	N55°E	12 lks
		8" Spruce	S51°W	6 lks
19772 LCRC Orlando Doyle # 7319	Set 3/4" pipe			

B. Description of corner evidence found and/or method applied in restoring or reestablishing corner:

Found 3/4" pipe and three Doyle witnesses overgrown.

Cheboygan County
OCT 30 1996
Re-Monumentation

LIBER 010 PAGE 180

C. Description of monument for corner and accessories established to perpetuate locating the position of the corner:

also corners A-13, T38N, R2W A-1, T37N, R2W M-1 T37N, R3W

Set 5/8" x 30" rebar with Remonumentation Cap

8" Tamarack	N23°W	7.41'	Set nail w/tag
8" Tamarack	N43°E	10.56'	Set nail w/tag
6" Tamarack	S76°E	5.08'	Set nail w/tag
8" Tamarack	S39°W	5.82'	Set nail w/tag

STATE OF MICHIGAN
JAMES H. GRANGER
PROFESSIONAL SURVEYOR
No. 16041
LICENSED PROFESSIONAL SURVEYOR

Signed by James H Granger

Date 10-10-96

Surveyor's Michigan License No. 16041