

SURVEY & REMONUMENTATION

CHEBOYGAN COUNTY REMONUMENTATION CORNER

LAND CORNER RECORDATION CERTIFICATE
Filing Requirement of Act 74, Mich. P.A. 1970

MAY 15 1997
For corners in
CHEBOYGAN

COM. (County)

Located in: Corner Code #

- 1. Public Land Survey T 37N R 2W M-2
T ___ R ___
T 37 R 2W A-2
T ___ R ___
- 2. Property Controlling S ___ T ___ R ___
in Section S ___ T ___ R ___
- 3. Miscellaneous S ___ T ___ R ___
Property in Sec. S ___ T ___ R ___

RECEIVED
FOR RECORD
96 OCT 30 PM 12: 25
Joanna Shroy
CLERK/REGISTER
CHEBOYGAN COUNTY, MICHIGAN
Register of Deeds Stamp & File Number

- 4. Lot No. _____, Recorded Plat _____
- 5. Private Claims _____

I, JAMES H. GRANGER, in a field survey on SEPTEMBER 24, 19 96 do hereby state that under requirements of P.A. 74, Michigan P.A. of 1970, the corner points mentioned in lines 1 and 2 above were in conformance with regulations and rules therefore as required in the current manual of survey instructions of the United States Department of the Interior, Bureau of Land Management or by a decree of a Court of Law and for that the corner points mentioned in lines 3, 4 and 5 above were in conformance with the rules of the Michigan Board of Land Surveyors or by a Decree of a Court of Law; established, re-established, monumented, recovered, found as expressed below:

A	B	C	D	E	F	G	H	I	J	K	L	M
1												
2	6	5	4	3	2	1						
3												
4	7	8	9	10	11	12						
5												
6	18	17	16	15	14	13						
7												
8	19	20	21	22	23	24						
9												
10	30	29	28	27	26	25						
11												
12	31	32	33	34	35	36						
13												

NOTE: Not more than 2 corners, all in the same town and range, may be recorded on this certificate.


A. Description of original monument and accessories and/or subsequent restoration:

- 1840 Original Survey Set wood post 12" Cedar S17°W 10 lks
John Mullett 12" Cedar N20°E 9 lks
- 1994 LCRC 1" pipe
Norman Quaine #33984

B. Description of corner evidence found and/or method applied in restoring or reestablishing corner:

Found 1" pipe and four witnesses


Monument Restored

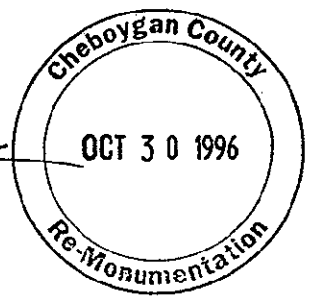

LIBER 010 PAGE 181

C. Description of monument for corner and accessories established to perpetuate locating the position of the corner:

- also A-2 T37N, R2W
- Set 5/8" x 30" rebar with Remonumentation Cap
- 1" Pipe
- 10" Cedar S77°E 15.13' Fd tag
- 6" Cedar S51°W 21.16' Fd tag
- 18" Cedar N76°W 15.61' Fd tag
- 5" Cedar N23°E 10.08' Fd tag

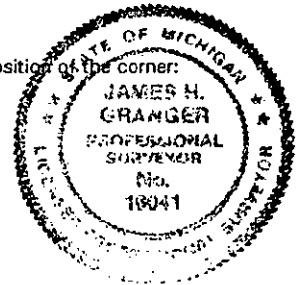

Signed by James H. Granger
Surveyor's Michigan License No. 16041

Date 10-10-96