

REMONUMENTATION

MAY 15 1997

CHEBOYGAN COUNTY REMONUMENTATION CORNER

LAND CORNER RECORDATION CERTIFICATE
Filing Requirement of Act 74, Mich. P.A. 1970

COMMISSION
For cornerers in
CHEBOYGAN

(County)	Located In:	Corner Code #
1. Public Land Survey	T. <u>37N</u> R. <u>3W</u>	<u>M-3</u>
	T. <u>37</u> R. <u>2W</u>	<u>(A-3)</u>
	T. <u> </u> R. <u> </u>	<u> </u>
2. Property Controlling in Section	S. <u> </u> T. <u> </u> R. <u> </u>	<u> </u>
	S. <u> </u> T. <u> </u> R. <u> </u>	<u> </u>
3. Miscellaneous Property in Sec.	S. <u> </u> T. <u> </u> R. <u> </u>	<u> </u>
	S. <u> </u> T. <u> </u> R. <u> </u>	<u> </u>

RECEIVED
FOR RECORD
96 OCT 30 PM 12: 26
Joanne Gray
CLERK/REGISTER
CHEBOYGAN COUNTY, MICHIGAN

Register of Deeds Stamp & File Number

4. Lot No. _____, Recorded Plat _____
5. Private Claims _____

A	B	C	D	E	F	G	H	I	J	K	L	M
1												
2	6	5	4	3	2	1						
3												
4	7	8	9	10	11	12						
5												
6	18	17	16	15	14	13						
7												
8	19	20	21	22	23	24						
9												
10	30	29	28	27	26	25						
11												
12	31	32	33	34	35	36						
13												

I, JAMES H. GRANGER, in a field survey on SEPTEMBER 24, 19 96 do hereby state that under requirements of P.A. 74, Michigan P.A. of 1970, the corner points mentioned in lines 1 and 2 above were in conformance with regulations and rules therefore as required in the current manual of survey instructions of the United States Department of the Interior, Bureau of Land Management or by a decree of a Court of Law and for that the corner points mentioned in lines 3, 4 and 5 above were in conformance with the rules of the Michigan Board of Land Surveyors or by a Decree of a Court of Law; established, re-established, monumented, recovered, found as expressed below:

NOTE: Not more than 2 corners, all in the same town and range, may be recorded on this certificate.

A. Description of original monument and accessories and/or subsequent restoration:


1840 Original Survey Set wood post 8" Tamarack N48°W 28 lks
John Mullett 8" Spruce S38°E 4 lks

1994 LCRC 1/2" rod w/cap # 15410
Norman Quaine #33984

B. Description of corner evidence found and/or method applied in restoring or reestablishing corner:

Found 1/2" rod with cap # 15410 and four witnesses.

Marcus A. Ross

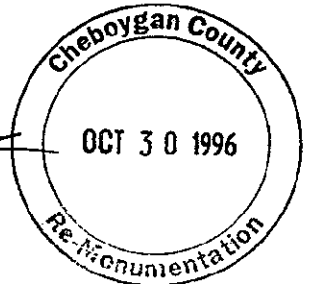

LIBER 010 PAGE 182

C. Description of monument for corner and accessories established to perpetuate locating the position of the corner. also corner A-3, T37N, R2W

Set 5/8" x 30" rebar with Remonumentation Cap

1/2" Rod			
7" Cedar	S15°W	14.19'	Fd tag
7" Triple Cedar	N26°W	12.87'	Fd tag
8" Cedar	N18°E	20.35'	Fd tag
8" Cedar	N58°E	12.90'	Fd tag



Signed by *James H. Granger*
Surveyor's Michigan License No. 16041

Date 10-10-96