

CHEBOYGAN COUNTY REMONUMENTATION CORNER

MAY 15 1987

LAND CORNER RECORDATION CERTIFICATE
Filing Requirement of Act 74, Mich. P.A. 1970

For corners in
CHEBOYGAN

(County)	Located in:	Corner Code #
1. Public Land Survey	T <u>37N</u> R <u>3W</u>	<u>M-5</u>
	T <u> </u> R <u> </u>	<u> </u>
	T <u>37</u> R <u>2W</u>	<u>A-5</u>
	T <u> </u> R <u> </u>	<u> </u>
2. Property Controlling in Section	S <u> </u> T <u> </u> R <u> </u>	<u> </u>
	S <u> </u> T <u> </u> R <u> </u>	<u> </u>
3. Miscellaneous Property in Sec.	S <u> </u> T <u> </u> R <u> </u>	<u> </u>
	S <u> </u> T <u> </u> R <u> </u>	<u> </u>

RECEIVED FOR RECORD
96 OCT 30 PM 12:28
Joanna Spray
CLERK/REGISTER
CHEBOYGAN COUNTY, MICHIGAN
Register of Deeds Stamp & File Number

4. Lot No. _____, Recorded Plat _____
5. Private Claims _____

A	B	C	D	E	F	G	H	I	J	K	L	M
2	6	5	4	3	2	1						
3												
4	7	8	9	10	11	12						
5												
6	18	17	16	15	14	13						
7												
8	19	20	21	22	23	24						
9												
10	30	29	28	27	26	25						
11												
12	31	32	33	34	35	36						
13												

I, JAMES H. GRANGER, in a field survey on SEPTEMBER 24, 19 96 do hereby state that under requirements of P.A. 74, Michigan P.A. of 1970, the corner points mentioned in lines 1 and 2 above were in conformance with regulations and rules therefore as required in the current manual of survey instructions of the United States Department of the Interior, Bureau of Land Management or by a decree of a Court of Law and /or that the corner points mentioned in lines 3, 4 and 5 above were in conformance with the rules of the Michigan Board of Land Surveyors or by a Decree of a Court of Law; established, re-established, monumented, recovered, found as expressed below:

NOTE: Not more than 2 corners, all in the same town and range, may be recorded on this certificate.


A. Description of original monument and accessories and/or subsequent restoration:

- 1840 Original Survey John Mullett Set wood post 16" Sugar N55°W 11 lks
6" Beech S45°E 35 lks
- 1960 MSHD - LCRC Dean Delemater 1/2" bar & broken glass
- 1980 Survey Orlando Doyle # 7319 Found 1/2" bar & broken glass
- 1991 LCRC Norman Quaine #33984 Found 1/2" bar & broken glass
Raised w/1/2" rod & cap # 15410

B. Description of corner evidence found and/or method applied in restoring or reestablishing corner:

Found 1/2" rod w/ cap # 15410 and three witnesses.


Marvin A. Ray

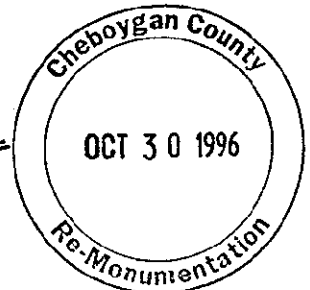

LIBER 010 PAGE 184

C. Description of monument for corner and accessories established to perpetuate locating the position of the corner: **also corner A-5, T37N, R2W**

- Set 5/8" x 30" rebar with Remonumentation Cap
- 1/2" Rod
- Power Pole S41°E 43.62' Fd tag
- Anchor Pole S64°E 84.85' Fd tag
- Anchor Pole N54°E 44.05' Fd tag
- 10" Birch N56°W 44.80' Set nail w/tag

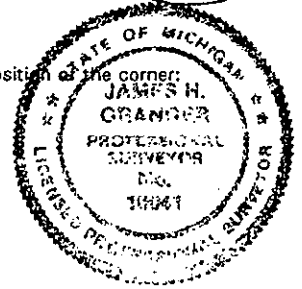

Signed by *James H. Granger*
Surveyor's Michigan License No. 16041

Date 10-10-96