

CHEBOYGAN COUNTY REMONUMENTATION CORNER

MAY 15 1996

LAND CORNER RECORDATION CERTIFICATE
Filing Requirement of Act 74, Mich. P.A. 1970

For corners in
CHEBOYGAN

(County)	Located in:	Corner Code #
1. Public Land Survey	T <u>37</u> N R <u>2W</u>	<u>M-9</u>
	T _____ R _____	_____
	T <u>37</u> N R <u>2W</u>	<u>A-9</u>
	T _____ R _____	_____
2. Property Controlling in Section	S _____ T _____ R _____	_____
	S _____ T _____ R _____	_____
3. Miscellaneous Property in Sec.	S _____ T _____ R _____	_____
	S _____ T _____ R _____	_____

RECEIVED FOR RECORD
96 OCT 30 PM 12:35

James H. Granger
CLERK/REGISTER
CHEBOYGAN COUNTY, MICHIGAN

Register of Deeds Stamp & File Number

4. Lot No. _____, Recorded Plat _____

5. Private Claims _____

1	A	B	C	D	E	F	G	H	I	J	K	L	M
2	6	5	4	3	2	1							
3													
4	7	8	9	10	11	12							
5													
6	16	17	16	15	14	13							
7													
8	19	20	21	22	23	24							
9													
10	30	29	28	27	26	25							
11													
12	31	32	33	34	35	36							
13													

I, JAMES H. GRANGER, in a field survey on SEPTEMBER 24, 1996 do hereby state that under requirements of P.A. 74, Michigan P.A. of 1970, the corner points mentioned in lines 1 and 2 above were in conformance with regulations and rules therefore as required in the current manual of survey instructions of the United States Department of the Interior, Bureau of Land Management or by a decree of a Court of Law and for that the corner points mentioned in lines 3, 4 and 5 above were in conformance with the rules of the Michigan Board of Land Surveyors or by a Decree of a Court of Law; established, re-established, monumented, recovered, found as expressed below:

NOTE: Not more than 2 corners, all in the same town and range, may be recorded on this certificate.


A. Description of original monument and accessories and/or subsequent restoration:

- | | |
|-----------------------------------------------------------|---------------------------|
| 1840 Original Survey Set wood post 10" Beech S81°W 16 lks | 1988 Survey Found 1" pipe |
| John Mullett 8" Sugar N71°E 7 lks | Delmer Porter # 15410 |
| 1963 Survey Metal Monument | 1988 Survey Found 1" pipe |
| Orlando Doyle # 7319 | James H. Granger # 16041 |
| 1968 Survey Metal Monument | 1990 Survey Found 1" pipe |
| Orlando Doyle # 7319 | James H. Granger # 16041 |
| 1972 Survey Found 3/4" pipe | 1994 Survey Found 1" pipe |
| Orlando Doyle # 7319 | James H. Granger # 16041 |
| 1986 Survey Metal Monument | 1994 Survey Found 1" pipe |
| Orlando Doyle # 7319 | Norman Quaine # 33984 |
| 1988 LCRC Found 1" pipe | |
| Delmer Porter # 15410 | |
| 1988 LCRC Found 1" pipe | |
| James H. Granger # 16041 | |

B. Description of corner evidence found and/or method applied in restoring or reestablishing corner:

Found 1" pipe and one witness.

Marcus A. Ford

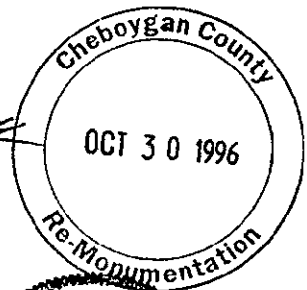


LIBER 010 PAGE 188

C. Description of monument for corner and accessories established to perpetuate locating the position of the corner also corner A-9, T37N, R2W

Set 5/8" x 30" rebar with Remonumentation Cap

- | | | | |
|-----------------|-------|---------|----------------|
| 1" Pipe | | | |
| Power Pole | N49°W | 44.55' | Fd tag # 15410 |
| SW Corner House | N51°E | 111.16' | Set nail w/tag |
| 14' Maple | N82°E | 83.60' | Set nail w/tag |
| 5" Elm | S28°E | 65.14' | Set nail w/tag |
| GTE Riser Box | S28°E | 73.18' | |

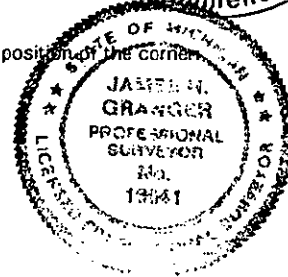

Signed by James H. Granger
Surveyor's Michigan License No. 16041

Date 10-10-96